


WELL PLUGGING RECORD

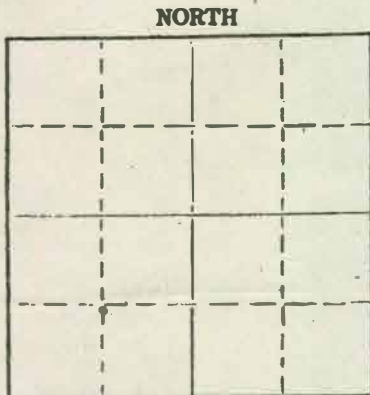

Locate well correctly on above
Section Plot

Ellsworth County. Sec 20 Twp 14 Rge 10 (E) W (W)
Location as "NE/CNWSW" or footage from lines SW SE NW
Lease Owner G. N. Rupe
Lease Name Prino #1 (Texaco Inc.) Well No. _____
Office Address Wichita, Kansas 67202
Character of Well (completed as Oil, Gas or Dry Hole) Dry Hole
Date well completed 12/10/1968
Application for plugging filed 3/21/1975
Application for plugging approved 19
Plugging commenced 3/24/75 19
Plugging completed 3/29/75 19
Reason for abandonment of well or producing formation depleted.
If a producing well is abandoned, date of last production 19
Was permission obtained from the Conservation Division or its agents before plugging was commenced? yes

Name of Conservation Agent who supervised plugging of this well Toman
Producing formation _____ Depth to top _____ Bottom _____ Total Depth of Well 3110 feet
Show depth and thickness of all water, oil and gas formations.

OIL, GAS OR WATER RECORDS

CASING RECORD

FORMATION	CONTENT	FROM	TO	SIZE	PUT IN	PULLED OUT
				8-5/8	319	none
				5 1/2"	3109	2028'

Describe in detail the manner in which the well was plugged, indicating where the mud fluid was placed and the method or methods used in introducing it into the hole. If cement or other plugs were used, state the character of same and depth placed, from _____ feet to _____ feet for each plug set.

Checked hole to 2492', ran sand to 2375' and ran 5 sacks cement.
Shot pipe at 2124', 2026', pulled 66 joints. Pumped 3 sacks hulls,
20 sacks gel and 85 sacks cement.

PLUGGING COMPLETE.

(If additional description is necessary, use BACK of this sheet)
Name of Plugging Contractor KNIGHT CASING PULLING CO., INC.
Address Chase, Kansas

STATE OF Rice COUNTY OF Kansas, ss.
Nesl J. Knight (employee of owner) or (owner or operator) of the above described
well, being first duly sworn on oath, says: That I have knowledge of the facts, statements, and matters herein contained and the log of the
above described well as filed and that the same are true and correct. So help me God.

(Signature) Nesl J. Knight
Chase, Kansas
(Address)

SUBSCRIBED AND SWORN to before me this 31st day of March, 19 75

My commission expires _____
NOTARY PUBLIC
MARGARET MELCHER
Rice County, Ks.
My Comm. Exp. Feb. 15, 1979

Margaret Melcher
Notary Public.

4/9/75
mailed
original
state court