

Ellsworth 27 14s 10w
COUNTY S T R

NE SW NE

LOCATION

Glen Rupe
OPERATOR

NO.

Holt FARM


ELEVATION: 1667 Gr.

Mr. Glen N. Rupe
925 Olive Garvey Building
Wichita, Kansas 67202

SCALE: 2" = 1 Mile

5' Wooden stake &
pink white flagging
in fairly level wheat
field

Appx 100' E of N-S waterway.
Appx. 300' SW of NW-SE Hwy.

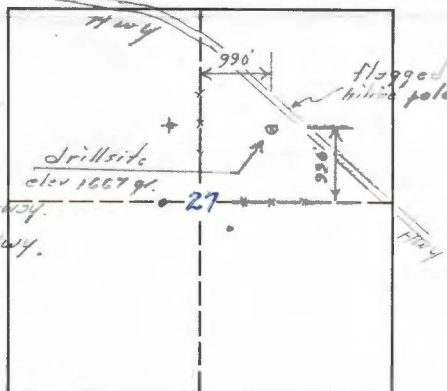

MINIMUM STAKING CHARGE: \$50.00

EXTRA TIME & MILEAGE: _____

ELEVATION CHARGE: _____

TOTAL: \$50.00

Thank you,
R. C. Moser
L-S ENGINEER