

State of Kansas



State Corporation Commission

CONSERVATION DIVISION

(Oil, Gas and Water)

P. O. Box 17027 3830 S. Meridian
WICHITA, KANSAS 67217

December 15, 1972

WELL PLUGGING AUTHORITY

Well No.	1
Lease	Holt
Description	SW NE NE 27-14-10W
County	Ellsworth
Total Depth	2955
Plugging Contractor	Jet Drilling Co., Inc.


G. N. Rupe
925 O. W. Garvey Bldg.,
Wichita, Kansas 67202

Gentlemen:

This is your authority to plug the above subject well in accordance with the Rules and Regulations of the State Corporation Commission.

This authority is void after 90 days from the above date.

Yours very truly,

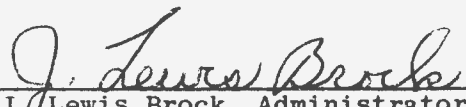
J. Lewis Brock, Administrator


Mr. Gilbert Toman Box 180 Holyrood, Kansas
is hereby assigned to supervise the plugging of the above
named well.

STATE OF KANSAS
STATE CORPORATION COMMISSION

Give All Information Completely
Make Required Affidavit
Mail or Deliver Report to:
Conservation Division
State Corporation Commission
P. O. Box 17027
Wichita, Kansas 67217
NORTH

WELL PLUGGING RECORD

Form CP-4

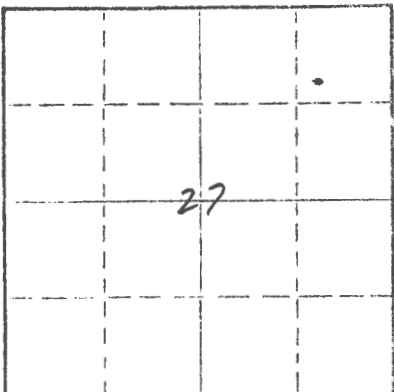

Locate well correctly on above
Section Flat

Ellsworth County, Sec. 27 Twp. 14S Rge. XX 10 (E) (W)
Location as "NE/CNW/SE" or footage from lines. C SW NE NE
Lease Owner Glen N. Rupe
Lease Name Holt
Office Address 925 Olive Garvey Bldg., Wichita, Kansas 67202
Character of Well (completed as Oil, Gas or Dry Hole) Dry hole
Date well completed December 12 1972
Application for plugging filed December 12 1972
Application for plugging approved December 12 1972
Plugging commenced December 12 (10 A.M.) 1972
Plugging completed December 12 1972
Reason for abandonment of well or producing formation Dry hole.
If a producing well is abandoned, date of last production nil 19
Was permission obtained from the Conservation Division or its agents before plugging was commenced? Yes

Name of Conservation Agent who supervised plugging of this well Gilbert Toman
Producing formation nil Depth to top Bottom Total Depth of Well 2,955 Feet
Show depth and thickness of all water, oil and gas formations.

OIL, GAS OR WATER RECORDS

CASING RECORD

FORMATION	CONTENT	FROM	TO	SIZE	PUT IN	PULLED OUT
0' - 115'	sub soil & sand					
115' - 251	shale	0	249'	8-5/8	249'	none

Describe in detail the manner in which the well was plugged, indicating where the mud fluid was placed and the method or methods used in introducing it into the hole. If cement or other plugs were used, state the character of same and depth placed, from feet to feet for each plug set.

Hole filled w/drllg. mud T. D. to 240'
240' - 165' cemented w/25 sack
165' - 40' drllg. mud
40' - 0' cemented w/10 sack
2 sacks cement in rat hole.
(plugged by hand - drilling contractor)

Name of Plugging Contractor Jet Drilling Company, Inc.
Address 514 - "120" Bldg., Wichita, Kansas 67202

STATE OF Kansas COUNTY OF Sedgwick
A. M. Scott (employee of owner) or (owner or operator) of the above-described well, being first duly sworn on oath, says: That I have knowledge of the facts, statements, and matters herein contained and the log of the above-described well as filed and that the same are true and correct. So help me God.

(Signature) A. M. Scott
514 - "120" Bldg., Wichita, Kansas 67202
December 72 (Address)



Commission Expires Mar. 22, 1975

Notary Public

Jet Drilling Co. owner
original to
Atwell
1/4/73