


Section 10 Township 14 Range 16 W

Well No. #1 Kuhn

Company Iron Drlg.

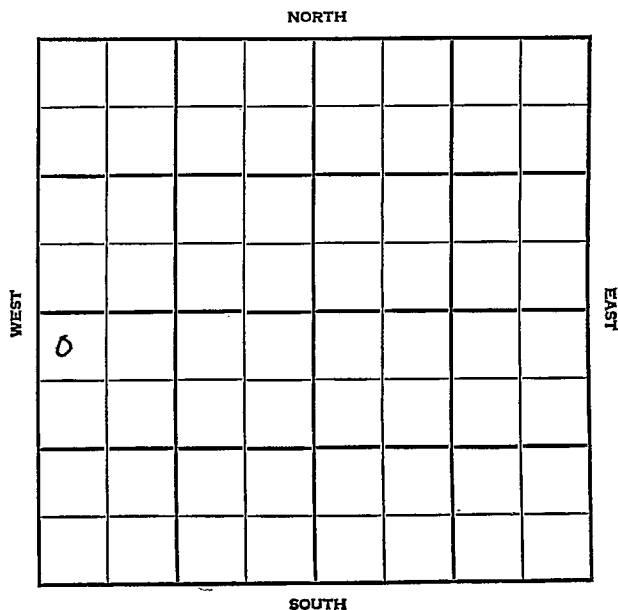


X

County EMIs Elev. _____
 Sec. 10 Twp. 1N Rge. 16W
 Company Iron Drlg.
 FarmName Kuhn No. 1

TOPS	DEPTH	LOG	DATUM	Loc. in Sec.																														
Anb.				NW NW SW																														
Tr.																																		
Dg.																																		
BL.																																		
L.				Geol. _____																														
K.C.				Contr. _____																														
B.K.C.				Co. tools																														
Ce.				Pool																														
C.				Wildcat																														
M.				<table border="1"> <tr><td></td><td></td><td></td></tr> <tr><td></td><td></td><td></td></tr> <tr><td></td><td></td><td></td></tr> <tr><td></td><td></td><td></td></tr> <tr><td></td><td></td><td></td></tr> <tr><td></td><td></td><td></td></tr> <tr><td></td><td></td><td></td></tr> <tr><td></td><td></td><td></td></tr> <tr><td></td><td></td><td></td></tr> <tr><td></td><td></td><td></td></tr> </table>																														
M.																																		
K.																																		
Mz.																																		
Ma.																																		
V.																																		
S.																																		
S.																																		
A.																																		
R.																																		
PE.																																		
G.																																		
TD.																																		

Date Comm. 8-21-55 Phillips & Carter DHM
8" @ 259 WOC

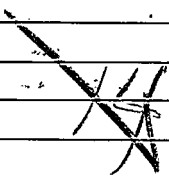

Co.
Lse.
No.
Sec.
T.
R.

AUG 24 1955
 FIRST REPORT

County Ellis Elev. 1919
 Sec. 10 Twp. 14S Rge. 16W
 Company Iron Drlg.
 FarmName Kuhn No. 1

TOPS	DEPTH	LOG	DATUM	Loc. in Sec.
Anh.				
Fp- <u>Et R</u>	<u>1724</u>			NW NW SW
H.	<u>3111</u>	<u>3114</u>	<u>1195</u>	
Tr.	<u>3131</u>	<u>3132</u>	<u>1213</u>	
Dg.				
Bl.				
L.	<u>3158</u>	<u>3159</u>	<u>1240</u>	
K.C.				Geol.
B.K.C.		<u>3396</u>	<u>1477</u>	Contr.
Ce.				
E- <u>Detri</u>		<u>3410</u>	<u>1491</u>	Co. tools
M.				Pool
M.				
K.				
Mz.				Wildcat
Me.				
V.				
S.				
S.				
A.		<u>3437</u>	<u>1518</u>	SEP 7 1955
R.				
PE.				
G.				
T.D.	<u>3459</u>			ABANDONED

Date Comm. 8/21/55 Phillips & Carter - DHM

8" 259 DST 3155-90 open 1 hr 40' wcm

BHP 675# 20" DST 3215-62 open 1 hr Rec.

40' slty wcm DST 3439-59 (failed)

DST 3442-59 open 1 hr Rec. 1805' sw

BHP ?

D & A