KANSAS


Form 51—5M—4-36—Palace

Russell

Section 10 Township 14 Range 15W

Well Number #3 Polcyn

Company Shaffer

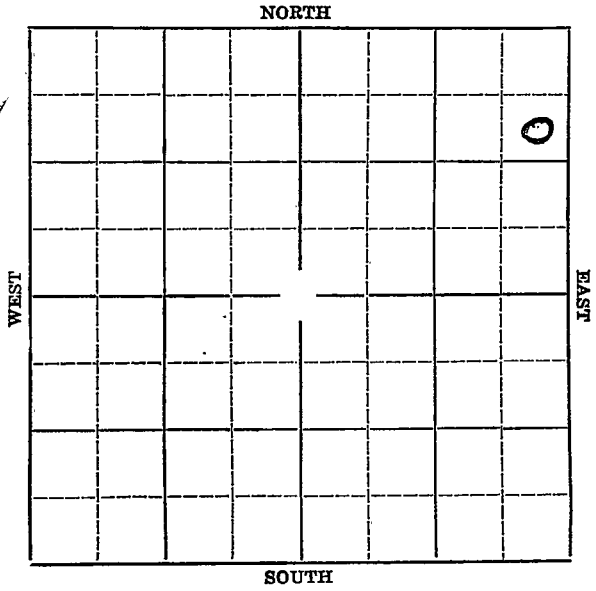

Form 252-A
5M 7-35 MPC

Russell

Map No. KANSAS Sec. 10 Twp. 14 R. 15W

Well No. #3 Polcyn Farm


Schaffer Company

990' Ft. from N. Line

_____ Ft. from S. Line

330' Ft. from E. Line

_____ Ft. from W. Line

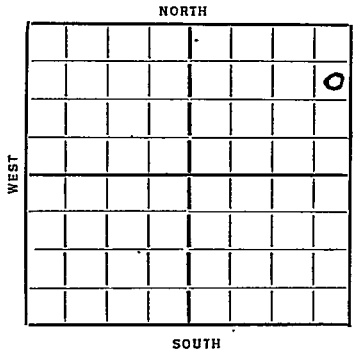

Date 1936	REPORT
6/3	Rig.
6/11	--
6/18	Rign. up.
6/25	Rig.
7/2	Drlg. 2735'.
7/9	6" @ 3255'. Rign up standard tools.
7/~~16~~	~~10" @ 6128' Waiting on cement~~
7/16	--
7/22	/36-Gorham 3267'.
	T.D. 3269'.
	1275 bbls of oil potential.
	COMPLETED

Form 26—1M Bks.—2-29

KANSAS

Russell


Map No. 72 Sec. 10 Twp. 14 R. 15W

Well No. 3 Polzin

Shaffer Company

Contractor

SECTION PLAT

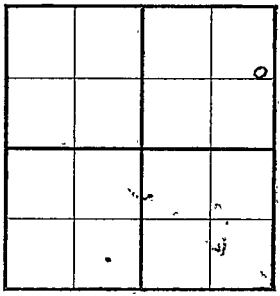

990 Ft. from N. Line

____ Ft. from S. Line

330 Ft. from E. Line

____ Ft. from W. Line

FIRST REPORT

Location ____

Rig up ____

Drilling and Remarks:

Rig

RECORD

Cased ____ in., ____ ft.

Sand ____

Gas ____

Oil ____

Total Depth ____

PRODUCTION

1st 24 hrs. Nat. ____

1st 24 hrs. after shot ____

Gas ____ Cu. Ft.

Dry Hole ____

Abandoned ____

Date

M 3 1935 19____

S. J. LEWIS Scout

Form 26—1M Bks.—2-29

Russell

KANSAS

Map No. 72 Sec. 10 Twp. 14 R. 15W


Well No. 3 Paloyan

Shaffer

Company

Contractor

SECTION PLAT

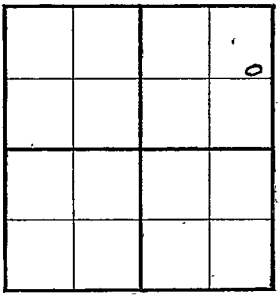

990 Ft. from N. Line

_____ Ft. from S. Line

330 Ft. from E. Line

_____ Ft. from W. Line

COMPLETED

Location _____

Rig up _____

Drilling and Remarks:

Gorham 3267

Pot 1275

RECORD

Cased _____ in., _____ ft.

Sand _____

Gas _____

Oil _____

Total Depth 3269

PRODUCTION

1st 24 hrs. Nat. _____

1st 24 hrs. after shot _____

Gas _____ Cu. Ft.

Dry Hole _____

Abandoned _____

Date

JUL 22 1936 19

S. J. LEWIS Scout