


Section 10 Township 14 Range 15W

Well No. #5 Poley

Company Foley et al

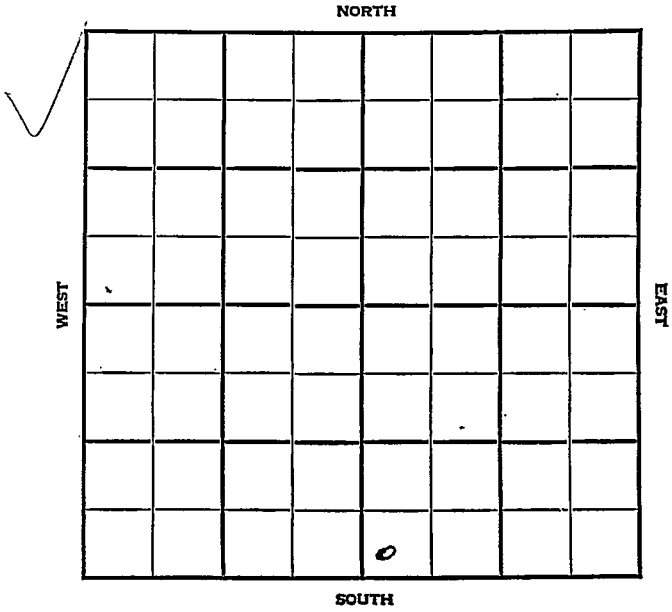

[Handwritten mark]

KANSAS

Russell

Sec. 10 Twp. 14 R. 15-W

Well No. #5 Polcyn Farm

Polcyn et al Company


Trapp Pool

_____ Ft. from N. Line

465' Ft. from S. Line

_____ Ft. from E. Line

330' Ft. from W. Line

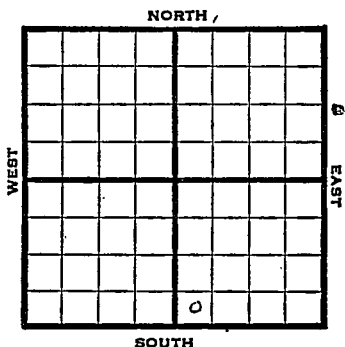

SW SE

1947

#lev. 1846' REPORT

11/25

Twin Well.
Drlg. 704'

12/3

1950' fsg.

12/10

8" @ 883'
TD 3250'
7" @ 3249'
RUST

12/17

"

12/30

"

1948

1/7

"

1/14

"

1/21

"

1/26

"

2/4

"

2/11

"

2/18

"

2/25

"

3/3

"

3/10

"

3/17

"

3/24

"

3/31

"

OVER

1948

4/7 8" @ 883'
7" @ 3249'
RUST

4/14 "

4/21 "

4/28 Gorham 3253'
TD 3254'
Swb. 30 bbls. oil in 18 hrs.

5/5 "

5/12 "

5/19 "

6/1 Gorham 3253'
7" @ 3249'
Pump 30 oil P_ot.
Gr. 40.9°
TD 3254'

COMPLETED

Map No. 72 Sec. 10 Twp. 14 R. 15W

Well No. 5 Polcyn

Polcyn etal. Company

COMPLETE

Contractor

SW SE

E11846
SECTION PLAT

 Ft. from N. Line

465 Ft. from S. Line

 Ft. from E. Line

330 Ft. from W. Line

Russell County

Location

Rig up

Drilling and Remarks:

*Good hole 3253
7" @ 3249
Pump 30 oil 100
40 I/G*

RECORD

Cased in., ft.

Sand

Gas

Oil /

Total Depth 3254

PRODUCTION

1st 24 hrs. Nat.

1st 24 hrs. after shot

Gas Cu. Ft.

Dry Hole

Abandoned

Date

JUN 1 1948 19

S. J. LEWIS Scout

Map No. _____ Sec. 10 Twp. 14 R. 15W

Well No. 5 Polcyn

Polcyn etal. Company

FIRST REPORT Contractor

SW SE

SECTION PLAT

_____ Ft. from N. Line

465 Ft. from S. Line

_____ Ft. from E. Line

330 Ft. from W. Line

Russell County

Location _____

Rig up _____

Drilling and Remarks:

twin well

drlg. 704

RECORD

Cased _____ in., _____ ft.

Sand _____

Gas _____

Oil _____

Total Depth _____

PRODUCTION

1st 24 hrs. Nat. _____

1st 24 hrs. after shot _____

Gas _____ Cu. Ft.

Dry Hole _____

Abandoned _____

Date

NOV 25 1947 19

S. J. LEWIS Scout