



Map No. KANSAS Sec. 10 Twp. 14 R. 15<sup>w</sup>


Well No. 1 Mills Farm  
Wolfe Creek etal Company

\_\_\_\_\_ Ft. from N. Line

330 Ft. from S. Line

\_\_\_\_\_ Ft. from E. Line

330 Ft. from W. Line

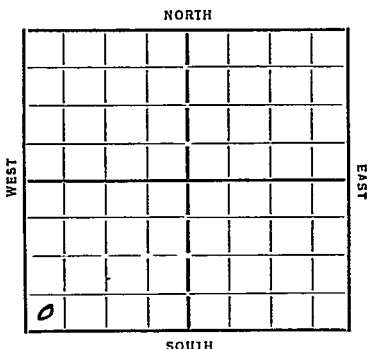

Date	REPORT
7/23/34	
9/18	Cellar
9/27	— 10/4 — 10/11 — 10/18 —
10/25	—
11/1	Log
11/8	B.R.
11/15	Rign
11/22	15" 357 C.O.
11/28	Dlg 625 12" 623
12/6	" 1895
12/13	10" 1900 8" 2360 A.G. 2460 CO
12/21	2487 3/4 M Has 212 8" 2733
12/27	Dlg 2790
1/3/35	8" 2726 Owell line 3018 6" 3020 S.O. 3028 CO 3050
1/10	T7 3084 Bail 15 Bbls per day 1000 acid
1/17	P. 130 Bbls 14 hrs Pull Rods
1/24	40 oil 30 W 24 hrs To acidify
1/31	P 20 oil & 15 W 12 hrs 1500 acid

(OVER)

Map No. 72 Sec. 10 Twp. 14 R. 15W

Well No. 1-Mills

Wolfe Creek et al Company

Contractor

SECTION PLAT


\_\_\_\_\_ Ft. from N. Line

330 Ft. from S. Line

\_\_\_\_\_ Ft. from E. Line

330 Ft. from W. Line

FIRST REPORTS

Location ✓

Rig up \_\_\_\_\_

Drilling and Remarks:

cellar

RECORD

Cased \_\_\_\_\_ in., \_\_\_\_\_ ft.

Sand \_\_\_\_\_

Gas \_\_\_\_\_

Oil \_\_\_\_\_

Total Depth \_\_\_\_\_

PRODUCTION

1st 24 hrs. Nat. \_\_\_\_\_

1st 24 hrs. after shot \_\_\_\_\_

Gas \_\_\_\_\_ Cu. Ft.

Dry Hole \_\_\_\_\_

Abandoned \_\_\_\_\_

Date

9-18-37 19

MANNSCHRECK

Scout

*Russell*

Map No. *77* Sec. *10* Twp. *14* R. *15W*

Well No. *1-Mills*

*Wolfe Creek et al* Company

Contractor

**GAS ABANDONED**

**SECTION PLAT**


..... Ft. from N. Line

*330* Ft. from S. Line

..... Ft. from E. Line

*330* Ft. from W. Line

Location.....

Rig up.....

Drilling and Remarks:

*1000 and*

*NO & FF*

**RECORD**

Cased..... in., ..... ft.

Sand *Complimentary*

Gas..... *3259*

Oil.....

Total Depth. *3307*

**PRODUCTION**

1st 24 hrs. Nat.....

1st 24 hrs. after shot.....

Gas..... Cu. Ft.

Dry Hole.....

Abandoned.....

Date

**ORVAL MANNSCHRECK**

*2-20-35* 192.....

Scout

2/7 70 oil & 29 water  
Rgn to Super

2/14 Run 5" 3195

2/20 Conglomerate 3259  
- 3307

1000 acid

D. & A.

**ABANDONED**