


Map No. 1 Sec 10 Twp. 14 R. 15

Well No. F-1111 Farm Crown Oil & Sacco Company

NORTH

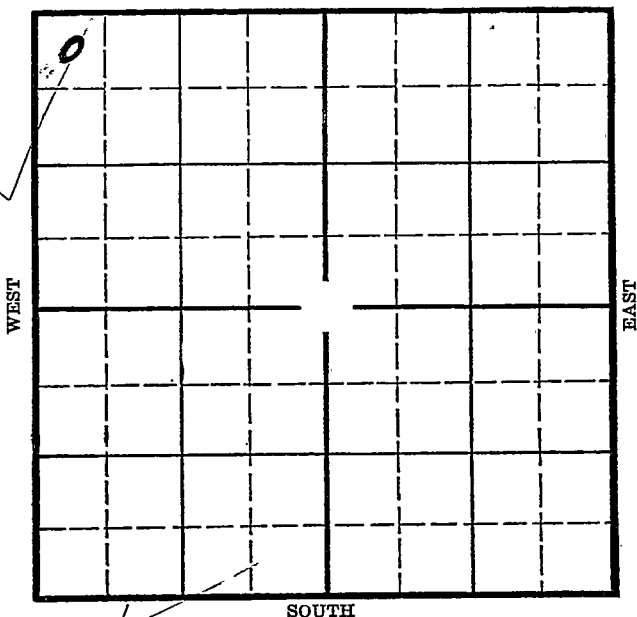

Location _____
Drilling Remarks _____

Rig Up_____

Drilling Remarks

RECORD

Cased_____in._____ft.

Sand

Gas

Oil_____

Total Depth_____

PRODUCTION

1st 24 hrs. Nat.-----

1st 24 hrs. after shot_____

Gas.....cu. ft.....

Dry Hole_____

Abandoned_____

Russell

Map No. KANSAS Sec. 10 Twp. 14 R. 15^W

Well No. 1- Mills Farm

Crown Oil & Sacco Company


330 Ft. from N. Line

_____ Ft. from S. Line

_____ Ft. from E. Line

330 Ft. from W. Line

Elev. 1864

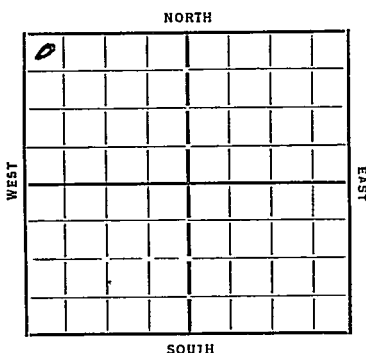

Date	REPORT
1935	
6/26	Location
7/3	Moving
7/11	Rgn
7/18	Alg 410
8/8	" 1600
8/15	" 2212
8/22	
8/29	8" 2524
9/6	Top 2730 8" 2736
	Alg 2755
9/20	Ok 3009
	T 2 3257
	D. A.

ABANDONED

Map No. 72 Sec. 10 Twp. 14 R. 15WWell No. 1 MillsCrown Oil & Saco Company

Contractor

SECTION PLAT

0			

330 Ft. from N. Line

.....Ft. from S. Line

.....Ft. from E. Line

330 Ft. from W. Line

FIRST REPORTS

Location ✓

Rig up.....

Drilling and Remarks:

RECORD

Cased.....in.,ft.

Sand.....

Gas.....

Oil.....

Total Depth.....

PRODUCTION

1st 24 hrs. Nat.....

1st 24 hrs. after shot.....

Gas.....Cu. Ft.

Dry Hole.....

Abandoned.....

Date

6/26/35 192

ORVAL MANNSCHRECK

Scout

Map No. 72 Sec. 10 Twp. 14 R. 15WWell No. 1-MillsCrown Oil & Gas CompanyABANDONED KANSAS Contractor

SECTION PLAT

0			

330 Ft. from N. Line

..... Ft. from S. Line

..... Ft. from E. Line

330 Ft. from W. Line

Location.....

Rig up.....

Drilling and Remarks:

NOT A

RECORD

Cased..... in., ft.

Sand 01 3009

Gas.....

Oil.....

Total Depth 3257

PRODUCTION

1st 24 hrs. Nat.....

1st 24 hrs. after shot.....

Gas..... Cu. Ft.

Dry Hole.....

Abandoned.....

Date

9-20-34 192.....ORVAL MANNSCHECK

Scout