

KANSAS

Form 51-5M-4-36-Palace


Russell

Section 10 Township 14 Range 15-W

Well Number #6-Polcyn

Company Shaffer

NORTH

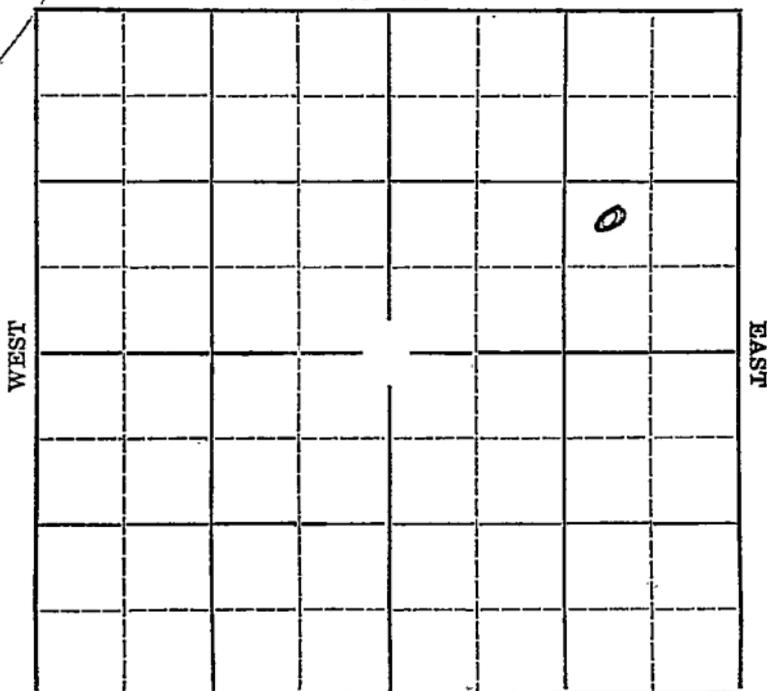

SOUTH

Sec. 10 Twp. 14 R. 15W

Well No. #6 Polcyn Farm
Shaffer Company


_____ Ft. from N. Line

990' Ft. from S. Line

990' Ft. from E. Line

_____ Ft. from W. Line

Elev 1865

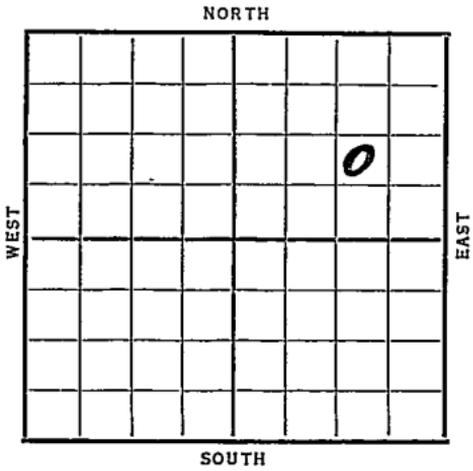

Date	REPORT
1936	
9/23	Location.
10/1--	10/8--
10/15	Surface hole.
10/22	10" @ 615'. Drlg. 2475'.
10/29	Drlg. 2510'.
11/6	Gorham Sand 3275 2400' oil Clean out
11/12	50' of 5" liner. Pump 454 bbls. 24 hrs.
11/19--	
11/27	Testing.
12/3--	12/10--
12/16	Gorham Sand 3275'. T. D. 3279'. Pot. 1574.
	COMPLETED

KANSAS

Map No. 72 Sec. 10 Twp. 14 R. 15W

Well No. 6. Polyan

Shayler Company
Contractor

SECTION PLAT

			0

_____ Ft. from N. Line

990 Ft. from S. Line

990 Ft. from E. Line

_____ Ft. from W. Line

FIRST REPORT

Location ✓

Rig up _____

Drilling and Remarks:

RECORD

Cased _____ in., _____ ft.

Sand _____

Gas _____

Oil _____

Total Depth _____

PRODUCTION

1st 24 hrs. Nat. _____

1st 24 hrs. after shot _____

Gas _____ Cu. Ft.

Dry Hole _____

Abandoned _____

Date

SEP 23 1936 19

S. J. LEWIS

Scout

KANSAS

Map No. 72 Sec. 10 Twp. 14 R. 15WWell No. 6 PolymShaffer Company

Contractor

SECTION PLAT

			0

 Ft. from N. Line990 Ft. from S. Line990 Ft. from E. Line Ft. from W. Line

COMPLETED

Location Rig up

Drilling and Remarks:

Get kam sand
8275Pol 1574

RECORD

Cased in., ft.Sand Gas Oil Total Depth 3279

PRODUCTION

1st 24 hrs. Nat. 1st 24 hrs. after shot Gas Cu. Ft.Dry Hole Abandoned

Date

DEC 16 1936¹⁹

S. J. LEWIS Scout