


Russell

Section 10 Township 14 Range 15-W

Well Number #8 Polcyn

Company Shaffer

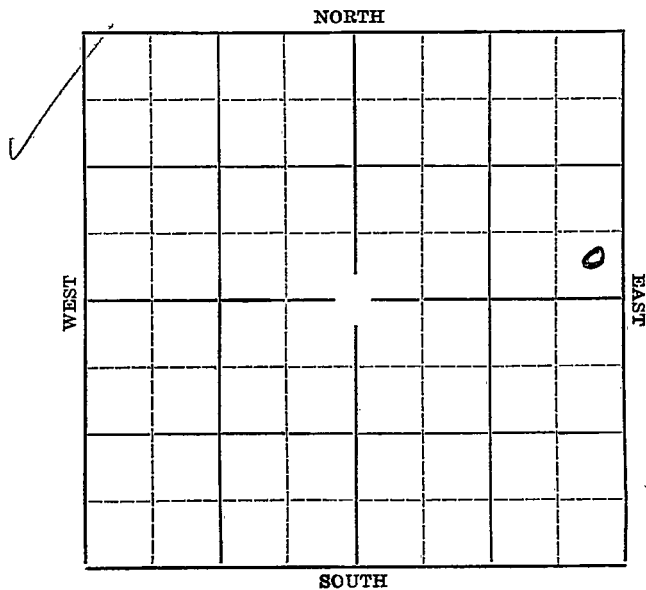

KANSAS


Russell

Sec. 10 Twp. 14 R. 15-WWell No. 8 Polcyn FarmShaffer

Company

 Ft. from N. Line330 Ft. from S. Line330 Ft. from E. Line Ft. from W. Line

Elev. 1813

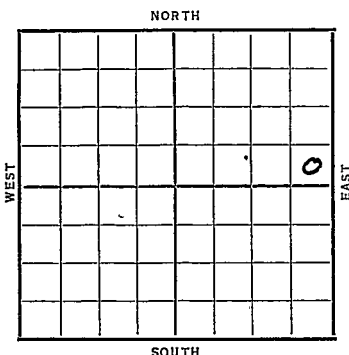

D236

REPORT

11/4 Location

11/12 Rig

11/19 --

11/27 Spud 100'.

12/3 10" @ 614'. WOC

12/10 Lansing 3020'. Drlg. 3060'.

12/17 7" @ 3240'. WOC.

12/29 Gorham 3253'. T. D. 3255½'.

Pot 805.

COMPLETED

KANSASMap No. 72 Sec. 10 Twp. 14 R. 15WWell No. 8 Polym.Shaffer Company

Contractor

SECTION PLAT

			0

_____ Ft. from N. Line

330 Ft. from S. Line330 Ft. from E. Line

_____ Ft. from W. Line

FIRST REPORTLocation ✓

Rig up _____

Drilling and Remarks:

RECORD

Cased _____ in., _____ ft.

Sand _____

Gas _____

Oil _____

Total Depth _____

PRODUCTION

1st 24 hrs. Nat. _____

1st 24 hrs. after shot _____

Gas _____ Cu. Ft.

Dry Hole _____

Abandoned _____

Date

NOV 4 1936

19

S. J. LEWIS

Scout

Russell KANSASMap No. _____ Sec. 10 Twp. 14 R. 15WWell No. 8 PolcynShaffer Company

Contractor

SECTION PLAT

_____ Ft. from N. Line

330 Ft. from S. Line330 Ft. from E. Line

_____ Ft. from W. Line

COMPLETED

Location _____

Rig up _____

Drilling and Remarks:

Graham 3253P 28805

RECORD

Cased _____ in., _____ ft.

Sand _____

Gas _____

Oil _____

Total Depth 3255 1/2

PRODUCTION

1st 24 hrs. Nat. _____

1st 24 hrs. after shot _____

Gas _____ Cu. Ft.

Dry Hole _____

Abandoned _____

Date

DEC 29 1936 19

S. J. LEWIS

Scout