FORM 51 5M 2-38 TPCO.

Russell

KANSAS

Section 10 Township 14 Range 15-W

Well No. 1 Witt

Company Wolf Creek

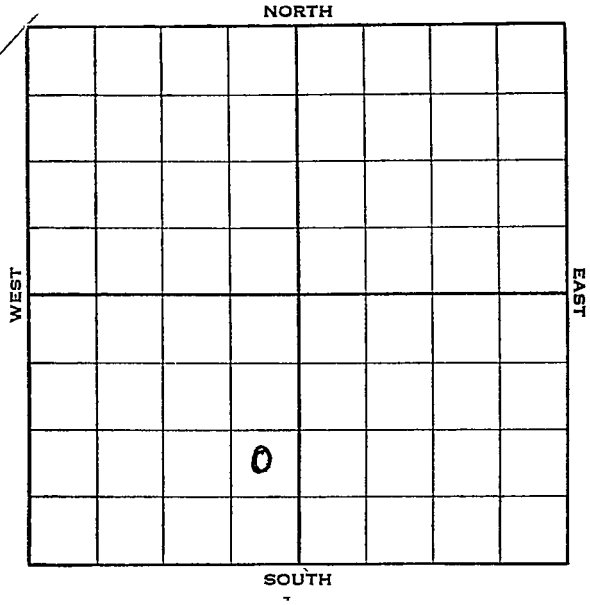

FORM 252-A 5M 1-38 KANSAS Russell

Sec. 10 Twp. 14 R. 15-W

Well No. #1 Witt Farm

Wolf Creek Company

Ft. from N. Line

990 Ft. from S. Line

330 Ft. from E. Line

Ft. from W. Line

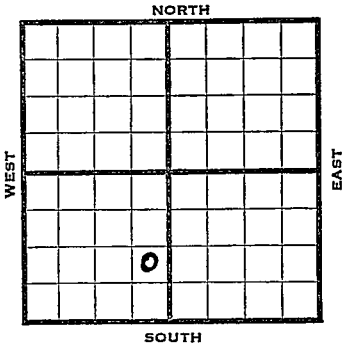

Elev. 1853

1938	REPORT
6/1	Location
6/10	B. C. R.
6/17	R.U.
6/24	15" @ 338'. Drlg. 395'.
7/1	12" - 549' 10" - 892'
	Drlg. 1228'
7/8	Drlg. 2255'.
7/15	8" - 2489'. Dlg. 2550'.
7/22	Drlg. 3055'.
7/29	Lans. 3025'. 7" - 3124'.
	T.D. 3253'. U. R. 7".
8/5	Gorham 3262-66'.
	1400' oil 1 hour. 7" - 3262'.
8/12	T.D. 3266'. 3100' oil.

OVER

1938

8/17 7" at 3262'.

Gorham 3262'.

T. D. 3266'.

Pump 402 bbls. 4 hrs. & 416 bbls. 4 hrs.

Potential 2410 bbls.

COMPLETED

Form 26—1M Bks.—2-29

Russell KANSAS

Map No. 22 Sec. 10 Twp. 14 R. 15W

Well No. 1 Witt

Wolf Creek Company

Contractor

FIRST REPORT

NE SE SW

Ft. from N. Line

990 Ft. from S. Line

330 Ft. from E. Line

Ft. from W. Line

SECTION PLAT

	O		

Location X

Rig up

Drilling and Remarks:

RECORD

Cased in., ft

Sand

Gas

Oil

Total Depth

PRODUCTION

1st 24 hrs. Nat.

1st 24 hrs. after shot

Gas Cu. Ft.

Dry Hole

Abandoned

Date

JUN 1 - 1938 19

H. D. Hatfield Scout

Form 26—1M Bks.—2-29

Russell KANSAS

Map No. 72 Sec. 10 Twp. 14 R. 15W

Well No. 1 Witt

Wolf Creek Company

Contractor

COMPLETED

NE SE SW

Ft. from N. Line

990 Ft. from S. Line

330 Ft. from E. Line

Ft. from W. Line

SECTION PLAT

	O		

Location

Rig up

Drilling and Remarks:

P-40 1/4 + 41 6/4

PoT 2410

RECORD

Cased 7 in., 3262 ft.

Sand Gorham 3262

Gas

Oil

Total Depth 3266

PRODUCTION

1st 24 hrs. Nat.

1st 24 hrs. after shot

Gas Cu. Ft.

Dry Hole

Abandoned

Date

AUG 17 1938 19

H. D. Hatfield Scout