


Section 10 Township 14 Range 15W

Well No. #1 Witt

Company Wormer Bradley Oil

NORTH

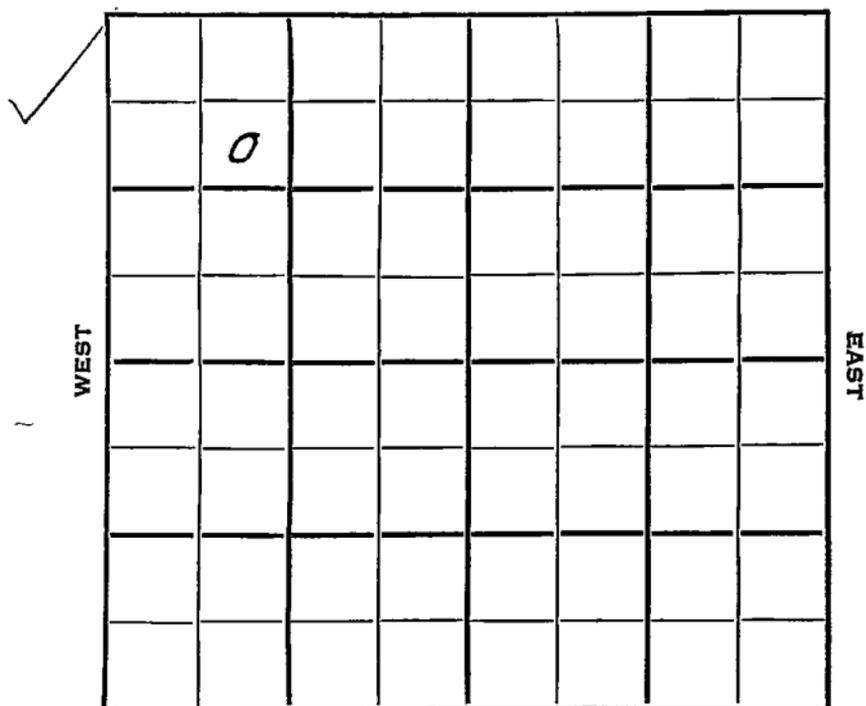

SOUTH

WEST

EAST



Sec. 10 Twp. 14 R. 15W

Well No. #1 Witt Farm

Wormer Bradley Oil Company

Rocket Drlg. Contractor

Gorham Pool


990 Ft. from N. Line

_____ Ft. from S. Line

_____ Ft. from E. Line

990 Ft. from W. Line

SE NW NW

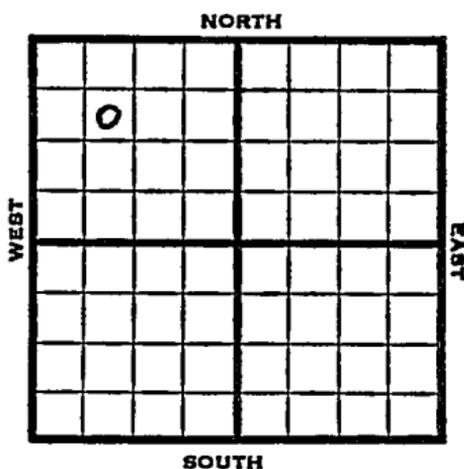

1953

Elev. 1861' REPORT

4/22 Spud 4-17-53
8" @ 901
Anhy 895
Drlg. 2270'

4/30 D&A
5/6 Spud 4-17-53 D & A TD 3267
8" @ 901 Anhy 895' Howard 2011'
Top 2747'
DST 2748-65 open 1/4 hr. rec 55' mud
Heeb 2972 Tor. 2991 Lans 3025
Gr. wash 3261 Granite 3266
TD 3267 D & A

ABANDONED


County Russell State Kansas

Sec. 10 (Blk. Twp.) 14 (Sur. Rge.) 15W Map No.

Operator Wormer Bradley Oil

Well No. 1 Farm Witt

Elev. _____ Location SE NW NW

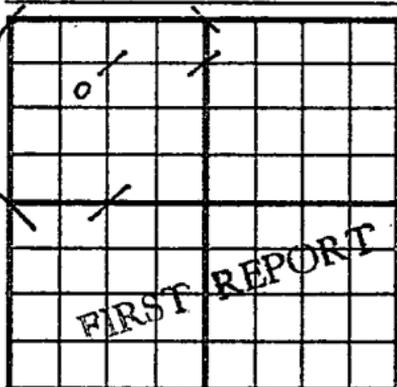

990 Ft. From N Line NW

990 Ft. From W Line Quarter

1st. Report ADD 2 1953

Completion _____

Remarks _____

Rocket Drlg. - Contr.

Spudding Date 4-17-53

Drlg. Data Gorham Pool

8" @ 901 Anhy 895 drlg. 2270

County Russell State KansasSec. 10 (Blk.
Twp.) 14 (Sur.
Rge.) 15W Map No.Operator Wormer-Bradley OilWell No. 1 Farm WittElev. 1861 Location SE NW NW990 Ft. From N Line NW990 Ft. From W Line Quarter

1st. Report

Completion MAY 6 1953Remarks Gorham PoolRocket Drlg. - Contr.Spudding Date 4-17-53Drlg. Data D & A TD 32678" @ 901 Anhy 895 Howard 2011Top. 2747 DST 2748-65 open $\frac{1}{2}$ hr.Rec. 55' mud Heeb. 2972 Tor. 2991Lans. 3025 Gr. wash 3261 Granite 3266TD 3267D & A