


Section 10 Township 14 Range 15-W

Well No. 2 Witt

Company Wolf Creek Oil

NORTH Gorham Pool

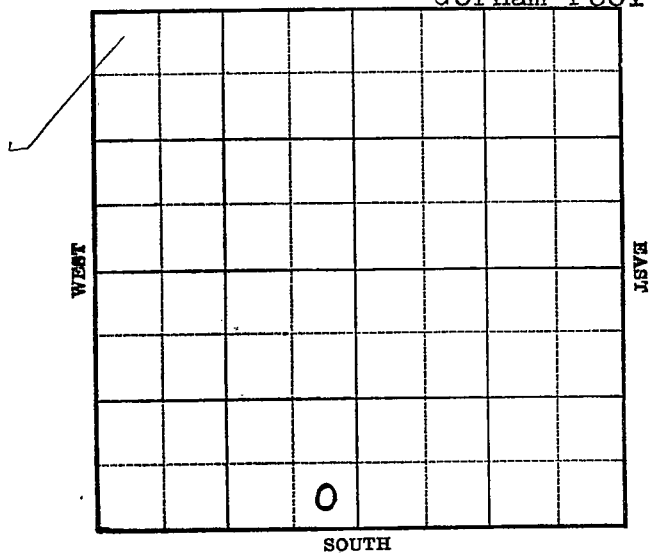

1939
4/26

7" - 3250'

Gorham 3250'

T. D. 3260'

Depthograph Potential 1727 bbls.

COMPLETED

Russell

KANSAS

Map No. _____ Sec. 10 Twp. 14 R. 15W

Well No. 2 Witt

Wolf Creek Oil Company

Contractor _____

FIRST REPORT

SE SW

SECTION PLAT

_____ Ft. from N. Line

330 Ft. from S. Line

330 Ft. from E. Line

_____ Ft. from W. Line

GORHAM POOL

Location _____

RECORD

Rig up _____

Cased _____ in., _____ ft.

Drilling and Remarks:

Sand _____

Drlg. 400

Gas _____

Oil _____

Total Depth _____

PRODUCTION

1st 24 hrs. Nat. _____

1st 24 hrs. after shot _____

Gas _____ Cu. Ft.

Dry Hole _____

Abandoned _____

Date

MAR 1 - 1939 19 H. D. Hatfield Scout

Russell

KANSAS

Map No. 72 Sec. 10 Twp. 14 R. 15WWell No. 2 Witt

Wolf Creek Oil

Company

Contractor

~~COMPLETED~~

SE SW

SECTION PLAT

_____ Ft. from N. Line

330 Ft. from S. Line330 Ft. from E. Line

_____ Ft. from W. Line

GORHAM POOL

Location _____

Rig up _____

Drilling and Remarks:

*Depthograph Pot**1727*

RECORD

Cased 7 in., 3250 ft.Sand Gorham 3250

Gas _____

Oil _____

Total Depth 3260

PRODUCTION

1st 24 hrs. Nat. _____

1st 24 hrs. after shot _____

Gas _____ Cu. Ft.

Dry Hole _____

Abandoned _____

Date

APR 26 1939

19

H. D. Hatfield Scout