

KANSAS Russell

Section 10 Township 14 Range 15W

Well No. #6 Witt

Company G R A

NORTH Gorham

WEST

EAST

SOUTH



Sec. 10 Twp. 14 R. 15W ✓

Well No. #6 Witt Farm.

C R A

Gorham Pool (C R A., Cont.) Company


_____ Ft. from N. Line

990' _____ Ft. from S. Line

990' _____ Ft. from E. Line

_____ Ft. from W. Line

NW SE SW

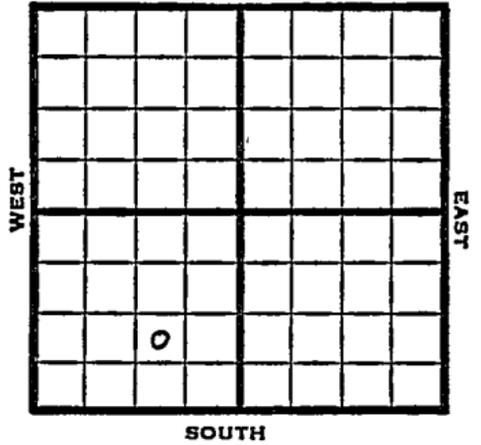

1949	Elev 1854' REPORT
9/14	Location
9/21	8" @ 895' Drlg. 1965'
9/28	Lansing 3022' Reagan 3261-62' TD 3262' 5"@ 3261'
10/5	TD 3265' Swb 17 bbls oil 7 hrs.
10/12	"
10/19	TD 3265' Reagan 3261' 5"@ 3261' Pump 51 Oil Pot 39 ⁸ Gr. Comp
COMPLETED	

Map No. _____ Sec. 10 Twp. 14 R. 15W

Well No. 6 Witt

C R A

Company

C R A

Contractor

NW SE SW

SECTION PLAT

	o		

_____ Ft. from N. Line

990 Ft. from S. Line

990 Ft. from E. Line

_____ Ft. from W. Line

Russell County

Location X

Rig up _____

Drilling and Remarks:

RECORD

Cased _____ in., _____ ft.

Sand _____

Gas _____

Oil _____

Total Depth _____

PRODUCTION

1st 24 hrs. Nat. _____

1st 24 hrs. after shot _____

Gas _____ Cu. Ft.

Dry Hole _____

Abandoned _____

Date

SEP 14 1949

19

S. J. LEWIS

Scout

Kansas

Map No. _____ Sec. 10 Twp. 14 R. 15W

Well No. 6 Witt

C R A

Company

COMPLETE

Contractor

NW SE SW

E 1, 1854
SECTION PLAT

_____ Ft. from N. Line
990 Ft. from S. Line
990 Ft. from E. Line
_____ Ft. from W. Line

	0		

Russell County

Location _____

Rig up _____

Drilling and Remarks:

Reagan 3261
3261 @ 3261
Prup 51 oil 084
395 SW

RECORD

Cased _____ in., _____ ft.
Sand _____
Gas _____
Oil _____
Total Depth *3265*

PRODUCTION

1st 24 hrs. Nat. _____
1st 24 hrs. after shot _____
Gas _____ Cu. Ft.
Dry Hole _____
Abandoned _____

Date

OCT 19 1949

19

S. J. LEWIS Scout