


Section 10 Township 14 Range 15-W

Well No. 2 Fee

Company Polcyn

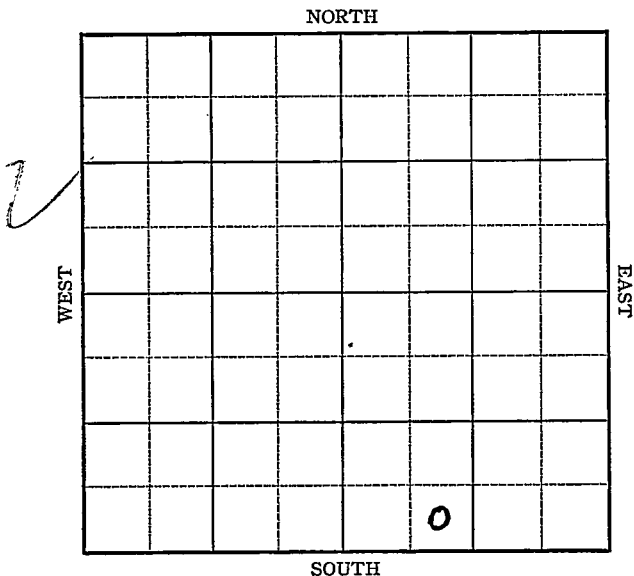

Sec. 10 Twp. 14 R. 15-W

Well No. #2 Fee Farm

Poleyn Company


 Ft. from N. Line

330 Ft. from S. Line

 Ft. from E. Line

990 Ft. from W. Line

Elev. 1851

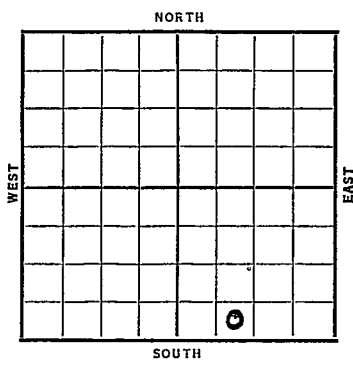

Date	REPORT
1937	
10/6	B.C.R.
10/15	Spud.
10/22	15" @ 410'. 13" @ 612'.
	Anhy 875'. 10" @ 882'.
	Drl g. 1340'.
10/29	Drl g. 2310'.
11/5	8" @ 2504'. Drl g. 2905'.
11/12	7" @ 3048'. T.D. 3050'. WOC.
11/17	7" @ 3048'.
	K.C. 3050'.
	T.D. 3059'.
	9000 acid.
	Potential 1417 bbls.
	COMPLETED

Russell **KANSAS**

Map No. _____ Sec. **10** Twp. **14** R. **15W**

Well No. **2 Fee**

Polcyn

Company _____

Contractor _____

FIRST REPORT

SECTION PLAT

SE SW SE

			o

_____ Ft. from N. Line

330 Ft. from S. Line

_____ Ft. from E. Line

990 Ft. from W. Line

Location _____

Rig up _____

Drilling and Remarks:

BCR

RECORD

Cased _____ in., _____ ft.

Sand _____

Gas _____

Oil _____

Total Depth _____

PRODUCTION

1st 24 hrs. Nat. _____

1st 24 hrs. after shot _____

Gas _____ Cu. Ft.

Dry Hole _____

Abandoned _____

Date

OCT - 6 1937

19

H. D. Hatfield Scout

Russell **KANSAS**

Map No. _____ Sec. **10** Twp. **14** R. **15W**

Well No. **2 Fee**

Polcyn Company

Contractor

COMPLETED
SE SW SE

_____ Ft. from N. Line

330 Ft. from S. Line

_____ Ft. from E. Line

990 Ft. from W. Line

SECTION PLAT

		X	X
		X	X

Location _____

Rig up _____

Drilling and Remarks:

9000 Acid

Pot-1417

RECORD

Cased 7 in., 3048 ft.

Sand KC 3050

Gas _____

Oil _____

Total Depth 3059

PRODUCTION

1st 24 hrs. Nat. _____

1st 24 hrs. after shot _____

Gas _____ Cu. Ft.

Dry Hole _____

Abandoned _____

Date

NOV 17 1937 19

H. D. Hatfield

Scout