


Section 10 Township 14 Range 15-W

Well No. #4 Fee

Company Polcyn Bros.

NORTH Gorham Pool

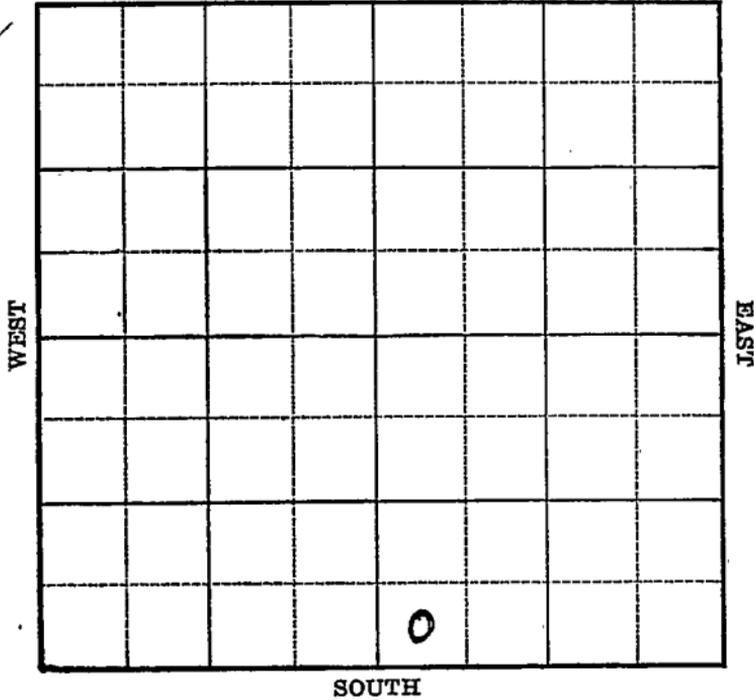

Sec. 10 Twp. 14 R. 15-WWell No. #4 Fee FarmPolcyn Bros. Company

(Gorham)


_____ Ft. from N. Line

330 Ft. from S. Line

_____ Ft. from E. Line

330 Ft. from W. Line

Elev. 1846

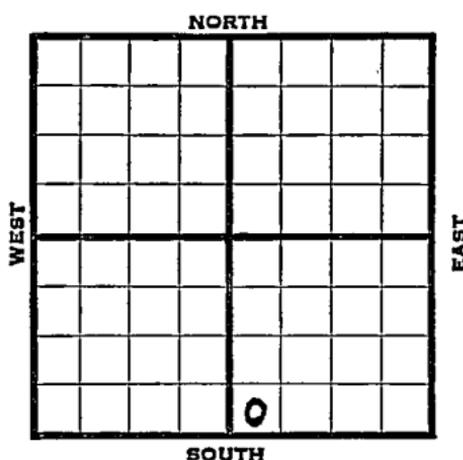

1939	REPORT
5/3	Location
5/12	R.O.G.
5/19	Rigging up cable rig.
5/26	20" - 50' 15" - 380'
	Drig. 575'
6/1	13" - 590' Anhy 875'
	10" - 880' Drig. 1625'
6/8	2338' run 8"
6/16	8" - 2477' Drig. 2715'
6/23	Topeka 2732' Lans. 3008'
	S.O. & G. 3032-38' Drig. 3120'
6/29	Shut down.
7/6	P.B.P.
7/12	Gorham 3251'
	7" - 3250'
	T.D. 3253'
	Depthograph Pot. 1787 bbls.
	COMPLETED

Russell KANSAS

Map No. 72 Sec. 10 Twp. 14 R. 15W

Well No. 4 Fee

Polcyn Bros Company

Contractor

FIRST REPORT

SECTION PLAT

SW SE

		0	

_____ Ft. from N. Line

330 Ft. from S. Line

_____ Ft. from E. Line

330 Ft. from W. Line

GORHAM POOL

Location ☒

Rig up _____

Drilling and Remarks:

RECORD

Cased _____ in., _____ ft.

Sand _____

Gas _____

Oil _____

Total Depth _____

PRODUCTION

1st 24 hrs. Nat. _____

1st 24 hrs. after shot _____

Gas _____ Cu. Ft.

Dry Hole _____

Abandoned _____

Date

MAY 3 1939 19

S. J. LEWIS Scout

Russell

KANSAS

Map No. _____ Sec. 10 Twp. 14 R. 15W

Well No. 4 Fee

Polcyn Bros.

Company

Contractor

COMPLETED

SECTION PLAT

SWISE

_____ Ft. from N. Line

330 Ft. from S. Line

_____ Ft. from E. Line

330 Ft. from W. Line

GORHAM POOL

Location _____

Rig up _____

Drilling and Remarks:

Goehorn 3251

7" @ 3250

*Depthograph #8
1987*

RECORD

Cased _____ in., _____ ft.

Sand _____

Gas _____

Oil _____

Total Depth 3253

PRODUCTION

1st 24 hrs. Nat. _____

1st 24 hrs. after shot _____

Gas _____ Cu. Ft.

Dry Hole _____

Abandoned _____

Date

JUL 12 1939 19

FWIS

Scout