


Russell

KANSAS

Section 10 Township 14 Range 15-W

Well No. 3 Fee

Company Polcyn Bros.

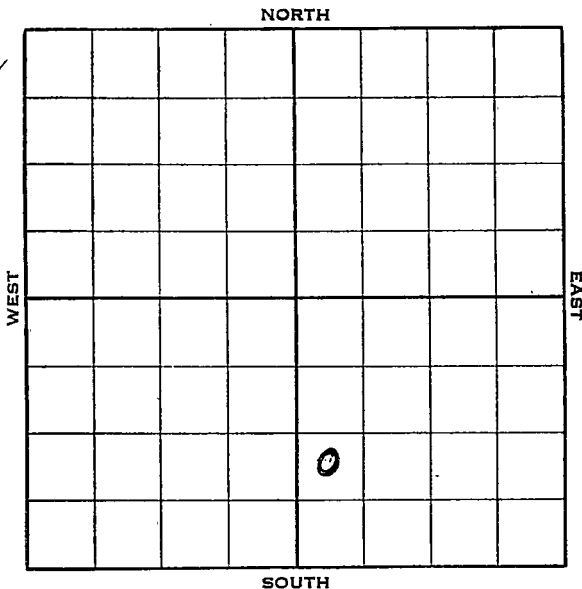

Sec. 10 Twp. 14 R. 15-W

Well No. #3 Fee Farm

Polcyn Bros. Company


 Ft. from N. Line

990 Ft. from S. Line

 Ft. from E. Line

330 Ft. from W. Line

Elev. 1851

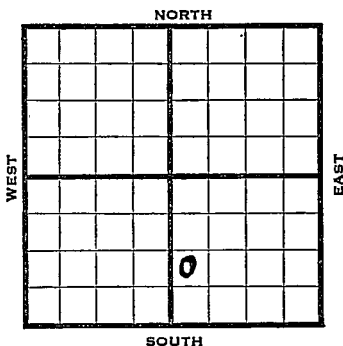

1938	REPORT
8/24	C. R.
9/2	15" - 405'. C. O.
9/9	Anh. 870'. 10" - 880'. Dlg. 1475'.
9/16	Drlg. 2375'.
9/23	8" - 2490'. Topeka 2695'. T.D. 2980' fsg.
9/30	Lans. 3004'. 6" - 3019'. S. O. & W. 3035-40'. 2 B.W. 3090-3115'. T.D. 3230'. U. R. 6".
10/7	Gorham 3251-53' T.D. 2800' oil 8 hrs. 6" - 3251' WOC
10/14	T. D. 3255'. 1000' oil.
10/19	6" - 3251'. Gorham 3251'. T. D. 3255'. Potential 1398 bbls.
	COMPLETED

Russell **KANSAS**Map No. 72 Sec. 10 Twp. 14 R. 15WWell No. 3 Fee**Polcyn Bros.**

Company

Contractor

FIRST REPORT**SECTION PLAT**

NW SW SE

_____ Ft. from N. Line

990 Ft. from S. Line

_____ Ft. from E. Line

330 Ft. from W. Line

		0	

Location _____

Rig up _____

Drilling and Remarks:

CR**RECORD**

Cased _____ in., _____ ft.

Sand _____

Gas _____

Oil _____

Total Depth _____

PRODUCTION

1st 24 hrs. Nat. _____

1st 24 hrs. after shot _____

Gas _____ Cu. Ft.

Dry Hole _____

Abandoned _____

Date

AUG 24 193819W. D. Hatfield Scout

Russell

Map No. _____ Sec. 10 Twp. 14 R. 15W

Well No. 3 Fee

Polcyn Bros. Company

Contractor

COMPLETED

SECTION PLAT

NW SW SE

_____ Ft. from N. Line

990 Ft. from S. Line

_____ Ft. from E. Line

330 Ft. from W. Line

		0	

Location _____

RECORD

Rig up _____

Cased 6 in., 3251 ft.

Drilling and Remarks:

Sand Gorham 3251

Gas _____

Oil _____

Total Depth 3255

PRODUCTION

1st 24 hrs. Nat. _____

1st 24 hrs. after shot _____

Gas _____ Cu. Ft.

Dry Hole _____

Abandoned _____

Pot 1298

Date

OCT 19 1938

L. D. Hatfield

19

Scout