


Section 10 Township 14 Range 15W

Well Number 5 ~~H. Polcyn~~ "B"
HELEN POLCYN

Company Transwestern Oil.

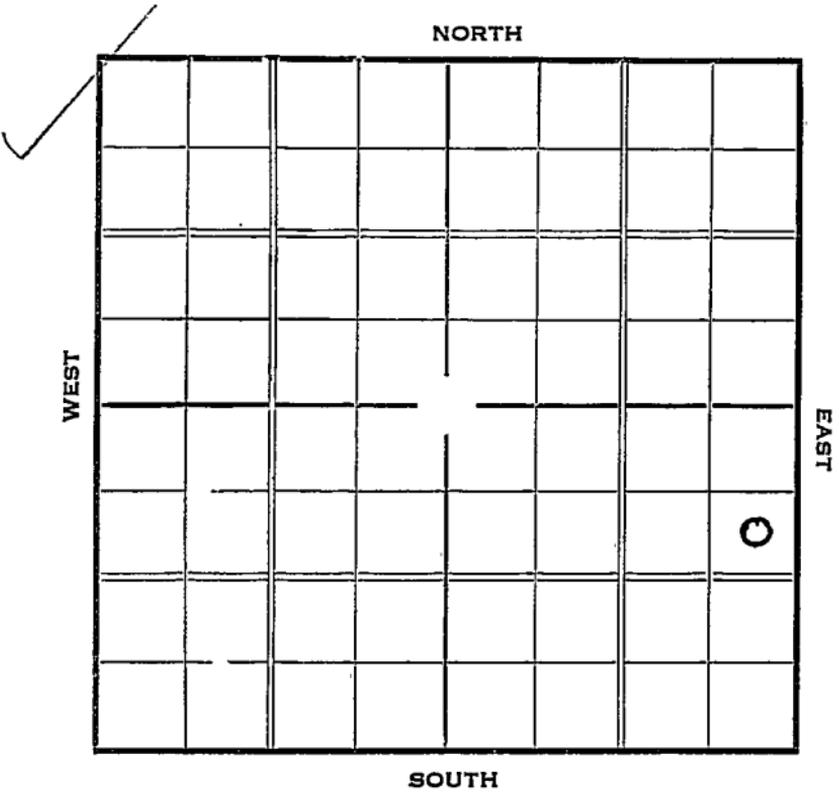

✓

Sec. 10 Twp. 14 R. 15-W

Well No. #5 *Helen Polcyn* ~~H. Polcyn "B"~~ Farm


Transwestern Oil Company

990 Ft. from N. Line

_____ Ft. from S. Line

330 Ft. from E. Line

_____ Ft. from W. Line

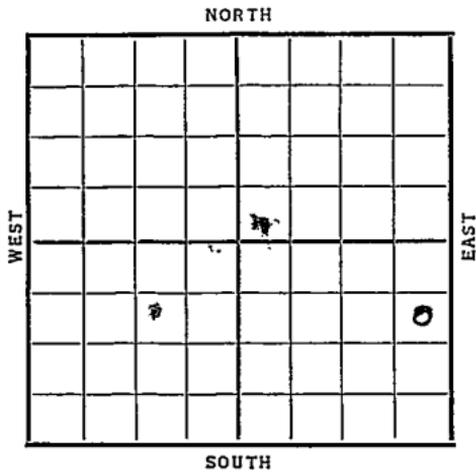

Date	REPORT
1937	
2/24	Rig
3/4	10" @ 615' WOC
3/11	Drlg. 2260'.
3/18	7" @ 3222 WOC
3/25	Gorham 3243'. T. D. 3244'. 2500' oil in hole.
3/31	Gorham sand 3243'. T. D. 3244'.
	Potential 686.
	COMPLETED

Map No. _____ Sec. 10 Twp. 14 R. 15W

Well No. 5 H. Polyan "B"

Transwestern Oil Company

Contractor _____

SECTION PLAT

990 Ft. from N. Line

_____ Ft. from S. Line

380 Ft. from E. Line

_____ Ft. from W. Line

FIRST REPORT

Location _____

Rig up _____

Drilling and Remarks:

Rig

RECORD

Cased _____ in., _____ ft.

Sand _____

Gas _____

Oil _____

Total Depth _____

PRODUCTION

1st 24 hrs. Nat. _____

1st 24 hrs. after shot _____

Gas _____ Cu. Ft.

Dry Hole _____

Abandoned _____

Date

FEB 24 1937

S. I. LEWIS Scout

KANSAS

Map No. 72 Sec. 10 Twp. 14 R. 15W

Well No. 5 Helen Polyzus

Transwestern Oil Company

Contractor

SECTION PLAT

			0

990 Ft. from N. Line

_____ Ft. from S. Line

330 Ft. from E. Line

_____ Ft. from W. Line

CORRECTION

RECORD

Location _____

Cased _____ in., _____ ft.

Rig up _____

Sand _____

Drilling and Remarks:

Gas _____

This was reported

Oil _____

as #5 Polyzus "B"

Total Depth _____

They have now

changed it to

the Helen Polyzus

Lease and

off the "B"

PRODUCTION

1st 24 hrs. Nat. _____

1st 24 hrs. after shot _____

Gas _____ Cu. Ft.

Dry Hole _____

Abandoned _____

Date

3/11 1937

S. J. LEWIS Scout

KANSAS *Russell*Map No. _____ Sec. *10* Twp. *14* R. *15W*Well No. *5 Helen Polgren**Transwestern* Company

Contractor _____

SECTION PLAT

			6

990 Ft. from N. Line

_____ Ft. from S. Line

330 Ft. from E. Line

_____ Ft. from W. Line

COMPLETED

RECORD

Location _____

Cased _____ in., _____ ft.

Rig up _____

Sand _____

Drilling and Remarks:

Gas _____

Grham Sand

Oil _____

*3243*Total Depth *3244**Potential*

PRODUCTION

686

1st 24 hrs. Nat. _____

1st 24 hrs. after shot _____

Gas _____ Cu. Ft.

Dry Hole _____

Abandoned _____

Date

MAR 31 1937

19

S. I. LEWIS Scout