


Section 10 Township 14 Range 15

Well No. 8 Helen Polcyn

Company Transwestern

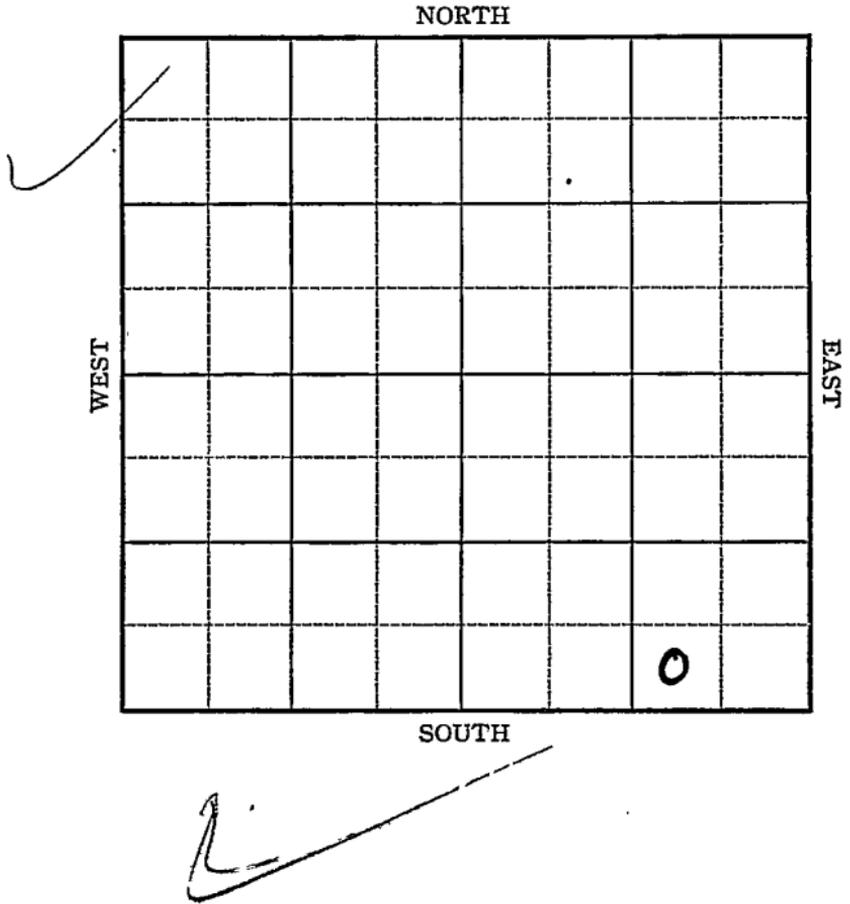

Sec. 10 Twp. 14 R. 15-W


Well No. #10 Helen Polcyn Farm  
Transwestern Company

990 Ft. from N. Line

\_\_\_\_\_ Ft. from S. Line

\_\_\_\_\_ Ft. from E. Line

990 Ft. from W. Line

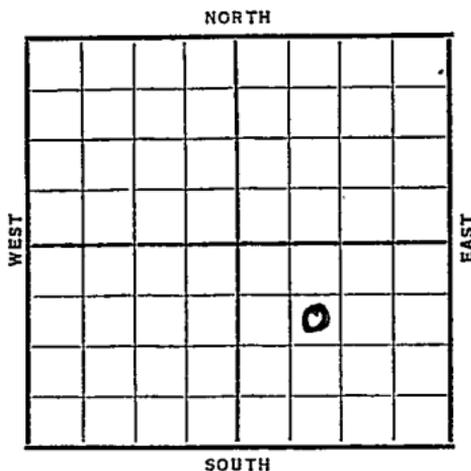

Elev. 1859

Date	REPORT
1937	
10/6	R U R
10/15	10" @ 578'. Drlg. 1889'.
10/22	Drlg. 3140'.
10/29	7" @ 3253'. WOC.
11/5	Gorham 3259'. T.D. 3262'.
	1700' oil.
11/10	7" @ 3253'.
	Gorham 3259'.
	T.D. 3262'.
	Potential 1105 bbls.
	COMPLETED

Russell KANSAS

Map No. \_\_\_\_\_ Sec. 10 Twp. 14 R. 15W

Well No. 8 Helen Polcyn

Transwestern Company

Contractor

**FIRST REPORT**

**SECTION PLAT**

SW SE S E

\_\_\_\_\_ Ft. from N. Line

330 Ft. from S. Line

990 Ft. from E. Line

\_\_\_\_\_ Ft. from W. Line

			0

Location \_\_\_\_\_

Rig up \_\_\_\_\_

Drilling and Remarks:

R.R.

*Handwritten mark*

**RECORD**

Cased \_\_\_\_\_ in., \_\_\_\_\_ ft.

Sand \_\_\_\_\_

Gas \_\_\_\_\_

Oil \_\_\_\_\_

Total Depth \_\_\_\_\_

**PRODUCTION**

1st 24 hrs. Nat. \_\_\_\_\_

1st 24 hrs. after shot \_\_\_\_\_

Gas \_\_\_\_\_ Cu. Ft.

Dry Hole \_\_\_\_\_

Abandoned \_\_\_\_\_

Date

OCT 6 1927 19

H. D. Hatfield

Scout

Russell KANSAS

Map No. \_\_\_\_\_ Sec. 10 Twp. 14 R. 15WWell No. 10 Helen PolcynTranswestern

Company

Contractor

COMPLETED

SE NW SE

990 Ft. from N. Line

\_\_\_\_\_ Ft. from S. Line

\_\_\_\_\_ Ft. from E. Line

990 Ft. from W. Line

## SECTION PLAT

		0	

Location \_\_\_\_\_

Rig up \_\_\_\_\_

Drilling and Remarks:

*POT. - 1105*

## RECORD

Cased 7 in., 3253 ft.Sand Gorham 3259

Gas \_\_\_\_\_

Oil \_\_\_\_\_

Total Depth 3262

## PRODUCTION

1st 24 hrs. Nat. \_\_\_\_\_

1st 24 hrs. after shot \_\_\_\_\_

Gas \_\_\_\_\_ Cu. Ft.

Dry Hole \_\_\_\_\_

Abandoned \_\_\_\_\_

Date

NOV 10 1937 19H. D. Hatfield Scout