


Map No. KANSAS Sec. 25 Twp. 14 R. 11W

Well No. 1 Stoppel
Douglas Oil Company
Contractor

SECTION PLAT

2640 Ft. from N. Line
..... Ft. from S. Line
1320 Ft. from E. Line
..... Ft. from W. Line

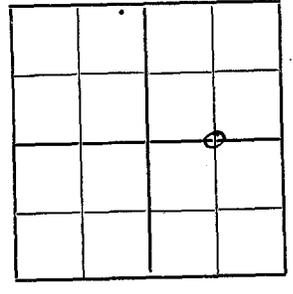

FIRST REPORTS

Location ----- Rig up ----- Drilling and Remarks: <u>Rig Bldg</u>	RECORD	
	Cased..... in.,	ft.
	Sand	
	Gas	
	Oil	
Total Depth.....		
PRODUCTION		
1st 24 hrs. Nat.		
1st 24 hrs. after shot.....		
Gas.....	Cu. Ft.	
Dry Hole.....		
Abandoned.....		


Date
MAR 28 1928
192..... S. J. LEWIS Scout

Map No. KANSAS Sec. 25 Twp. 14 R. 11W

Well No. 1 Stoppel
Douglas Oil Company
Contractor

SECTION PLAT

2640 Ft. from N. Line
..... Ft. from S. Line
1320 Ft. from E. Line
..... Ft. from W. Line

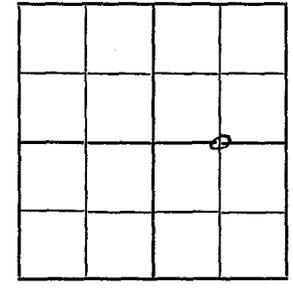

ABANDONED

Location ----- Rig up ----- Drilling and Remarks: <u>3435-40 hole full water Total Depth 3503 D & A</u>	RECORD	
	Cased..... in.,	ft.
	Sand	
	Gas	
	Oil	
Total Depth.....		
PRODUCTION		
1st 24 hrs. Nat.		
1st 24 hrs. after shot.....		
Gas.....	Cu. Ft.	
Dry Hole.....		
Abandoned.....		

Date
AUG 1 1928
192..... S. J. LEWIS Scout

FORM 25 250 BKS. 4-25 WESTERN

MAP NO. _____ SEC. 25 TWP. 14S R. 11W
 WELL NO. 1- Stoppel
Rough COMPANY

Map No. _____ Sec. 25 Twp. 14 R. 11W
 Well No. 1- Stoppel Farm
Houghland Oil Company


CONTRACTOR _____

 FT. FROM N. LINE


 FT. FROM S. LINE

 FT. FROM E. LINE

 FT. FROM W. LINE

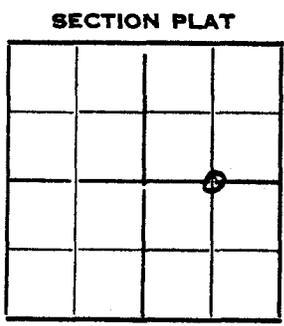

2640 Ft. from N. Line
 _____ Ft. from S. Line
1320 Ft. from E. Line
 _____ Ft. from W. Line

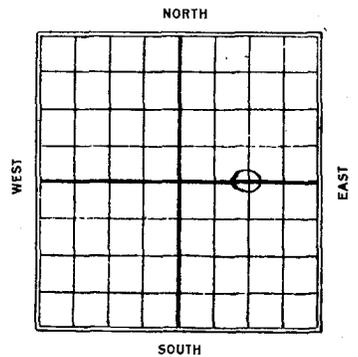

LOCATION _____
 RIG UP _____
 DRILLING AND REMARKS:

RECORD
 CASED _____ IN. _____ FT.
 SAND _____
 GAS _____
 OIL _____
 TOTAL DEPTH 3503

PRODUCTION
 1ST 24 HRS. NAT. _____
 1ST 24 HRS. AFTER SHOT _____
 GAS _____ CU. FT.
 DRY HOLE
 ABANDONED


DATE 7/1 1928 SCOUT _____

Date	REPORT
3/28	Rig Bldg.
4/4	Rig
4/11	—
4/18	—
4/25	Rigged up-
5/2	Drlg 1185-
5/9	Show oil 1335. Drlg 1660-
5/16	Drlg 1770-
5/23	" 2005
5/31	" 2625
6/6	" 2800
6/13	T.D. 2820 - u.R. 8"
6/20	Drlg 3025
6/27	" 3187
7/3	T.D. 3187 - S.D.
7/11	Drlg 3225'
7/18	T.D. 3355 - u.R. 6"
7/25	Drlg 3395
8/1	3435 - 40 H.F.W.
	T.D. 3503
	Abandoned 3503

Map No. **KANSAS** Sec. 25 Twp. 14 R. 11W

Well No. 1 Stapfel Farm

Douglass Company
NORTH

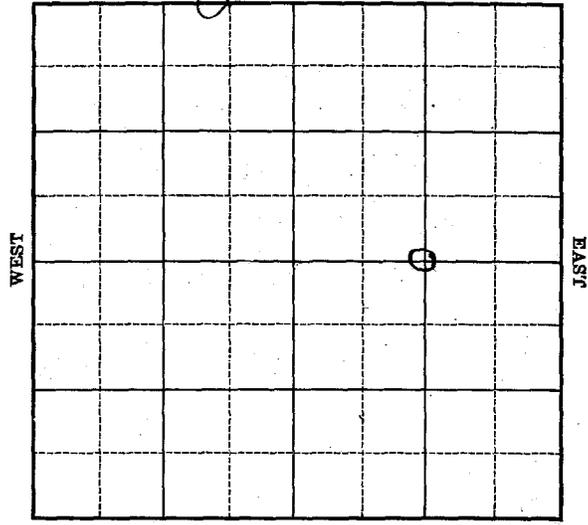

Location _____

Rig Up _____

Drilling Remarks _____

Drilling Remarks _____

RECORD

PRODUCTION

Cased _____ in. _____ ft.

1st 24 hrs. Nat. _____

Sand _____

1st 24 hrs. after shot _____

Gas _____

Gas _____ cu. ft.

Oil _____

Dry Hole _____

Total Depth _____

Abandoned _____