

Russell

KANSAS
 Map No. 56 Sec. 21 Twp. 14 R. 11W

Well No. 1 Short

Frontier Fuel


Company

FIRST REPORT

Contractor

SW NE NW

SECTION PLAT

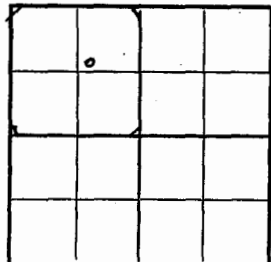

990 Ft. from N. Line

Ft. from S. Line

990 Ft. from E. Line

Ft. from W. Line

Wildcat

Location

RECORD

Cased in, ft.

Sand

Gas

Oil

Total Depth

PRODUCTION

1st 24 hrs. Nat.

1st 24 hrs. after shot

Gas Cu. Ft.

Dry Hole

Abandoned

Date

FEB 9 1944 19

S. J. LEWIS

Scout

Russell

KANSAS
 Map No. 56 Sec. 31 Twp. 14 R. 11W

Well No. 1 Short

Frontier Fuel


Company

CORRECTION

Contractor

SW NE NW

SECTION PLAT

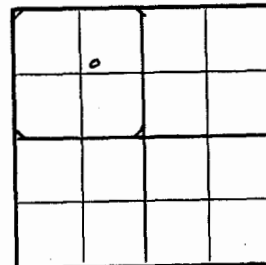

990 Ft. from N. Line

Ft. from S. Line

990 Ft. from E. Line

Ft. from W. Line

Wildcat

Location

RECORD

Cased in, ft.

Sand

Gas

Oil

Total Depth

PRODUCTION

1st 24 hrs. Nat.

1st 24 hrs. after shot

Gas Cu. Ft.

Dry Hole

Abandoned

Date

FEB 16 1944 19

S. J. LEWIS

Scout

Form 26, 200 Bls 5-42 Petrol **Russell**

Map No. 56 Sec. 31 Twp. 14 R. 11W

Well No. 1 Short

Frontier Fuel Company

ABANDONED Contractor

SW NE NW


990 Ft. from N. Line

 Ft. from S. Line

990 Ft. from E. Line

 Ft. from W. Line

SECTION PLAT

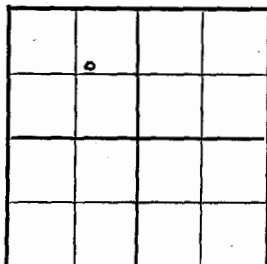

Wildcat

Location

Rig up

Drilling and Remarks:

BKC 3082

Cong 3093

Arb 3158

RECORD

Cased in., ft.

Sand

Gas

Oil

Total Depth 3185

PRODUCTION

1st 24 hrs. Nat.

1st 24 hrs. after shot

Gas Cu. Ft.

Dry Hole

Abandoned

Date

MAR 1 1944 19 S. J. LEWIS Scout

FORM 25
5M 9-41 **KANSAS**

Russell

Sec. 31 Twp. 14 R. 11W

Well No. #1 Short Farm

Frontier Fuel Company

Wildcat


990 Ft. from N. Line

 Ft. from S. Line

990 Ft. from E. Line

 Ft. from W. Line

SW NE NW *21639*

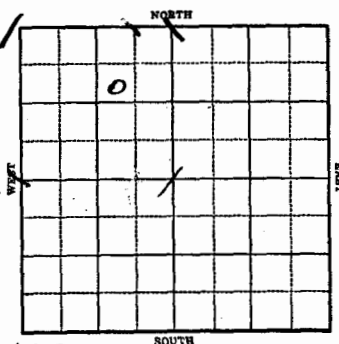

REPORT

1944

2/9

Rotary

2/15

8" @ 330

Anhy 503

Drlg. 1845

2/23

Lens 2795

Drlg. 2950'

3/1

BKC 3082

Cong 3093

Arb 3158

TD 3185'

ABANDONED

FOR KANSAS
PETROL

Russell

Section 31
21 Township 14 Range 11W

Well No. #1 short (Smith 1)

Company Frontier Fuel (Kingwood O.I.)

