

KANSAS

Map No. 56 Sec. 33 Twp. 14 R. 11WWell No. 1 StumpfLion Oil Refining etal Company

FIRST REPORT

Contractor

NW NE NE

SECTION PLAT


330 Ft. from N. Line

Ft. from S. Line

990 Ft. from E. Line

Ft. from W. Line

Wildcat

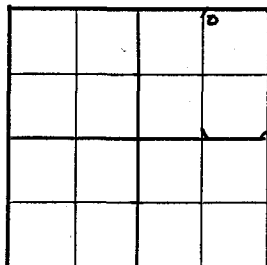

Location

RECORD

Cased _____ in., _____ ft.

Sand _____

Gas _____

Oil _____

Total Depth _____

PRODUCTION

1st 24 hrs. Nat. _____

1st 24 hrs. after shot _____

Gas _____ Cu. Ft.

Dry Hole _____

Abandoned _____

Date

SEP 8 1943

19

S. J. LEWIS Scout

KANSAS

Map No. 56 Sec. 33 Twp. 14 R. 11WWell No. 1 StumpfLion Oil Ref. etal. Company

ABANDONED

Contractor

SECTION PLAT

NW NE NE


330 Ft. from N. Line

Ft. from S. Line

990 Ft. from E. Line

Ft. from W. Line

Wildcat

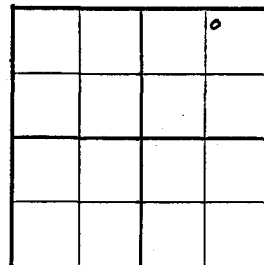

Location

RECORD

Cased _____ in., _____ ft.

Sand _____

Gas _____

Oil _____

Total Depth 9287

PRODUCTION

1st 24 hrs. Nat. 2 1/2

1st 24 hrs. after shot _____

Gas _____ Cu. Ft.

Dry Hole _____

Abandoned _____

Date

SEP 29 1943

19

S. J. LEWIS Scout


KANSAS

Russell

Sec. 33 Twp. 14 R. 11-W

Well No. #1 Stumpf Farm

Lion Oil Refining etal Company

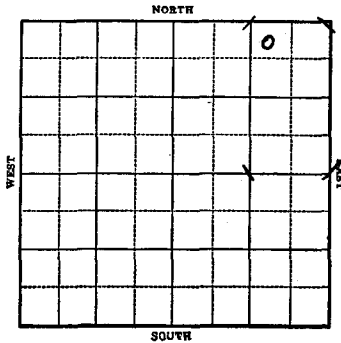

330 Ft. from N. Line

Ft. from S. Line

990 Ft. from E. Line

Ft. from W. Line

1943 REPORT

9/8 Derrick
9/15 Surface hole
9/22 Anhy 540
Florence 1570
Topeka 2480
Drlg. 2600'
9/29 Lans 2815'
Aro 3176
No shows
T.D. 3237'

ABANDONED

KANSAS

Russell

Section 33 Township 14 Range 11-W

Well No. #1 Stumpf

Company Lion Oil Refining etal

