

Section 11 Township 14 Range 31WWell No. #1 SharpCompany D. R. Lauck

NORTH

WEST	0							
EAST								

SOUTH

Gove

KANSAS

Sec. 11 Twp. 14 R. 31W

Well No. #1 Sharp Farm

D. R. Lauck Company

D. R. Lauck - Contr. Contractor

Wildcat


330' Ft. from N. Line

 Ft. from S. Line

 Ft. from E. Line

330' Ft. from W. Line

NW NW NW

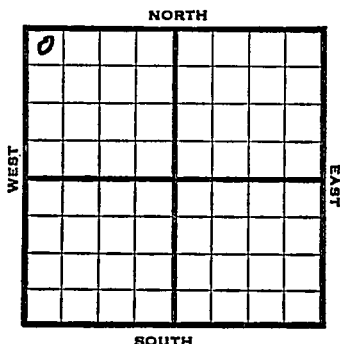

1952

Elev. 2851' ~~3051'~~ REPORT

7/2

Spud date 6-26-52
8" @ 185
Drlg. 3095'

7/16

Spud 6-26-52
D & A TD 4667' 8" @ 185
Lans. 3923' B KC 4261' Marm. 4280'
Cherokee 4397'
DST 4491-4530 open 1 hr. rec 63' mud
SSO 520# Miss 4562'
TD 4667' D & A

ABANDONED

County Gove State KansasSec. 11 (Bk. 14 (Sur. 31W Map No. 14) (Twp.) (Rge.)Operator D. R. LauckWell No. 1 Farm SharpElev. 330 Location NW NW NW

0									


330 Ft. From N Line NW330 Ft. From W Line Quarter1st. Report JUL 2 1952

Completion

Remarks

D. R. Lauck - Contr.Spudding Date 6-26-52Drlg. Data Wildcat8" @ 185 Drlg. 3095

J. G. McGEHEE

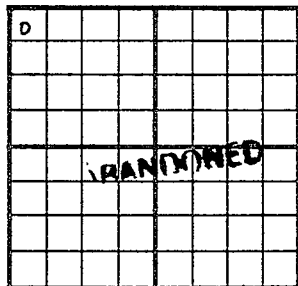County Gove State KansasSec. 11 (Blk.) 14 (Sur.) 31W Map No.Operator D. R. LauckWell No. 1 Farm SharpElev. 3851 Location NW NW NW330 Ft. From N Line NW330 Ft. From W Line Quarter

1st. Report

Completion JUL 16 1952Remarks WildcatD.R. Lauck - Contr.Spudding Date 6-26-52Drlg. Data D & A TD 46678" @ 185 Lans. 3923 B KC 4261Marm. 4280 Cherokee 4397 DST 4491-4530open 1 hr. Rec. 63' mud SSO 520#Miss. 4562 TD 4667D & A