


Section 11 Township 14 Range 34W

Well No. #1 Newcomb

Company Gerald Gordon & Wycoff

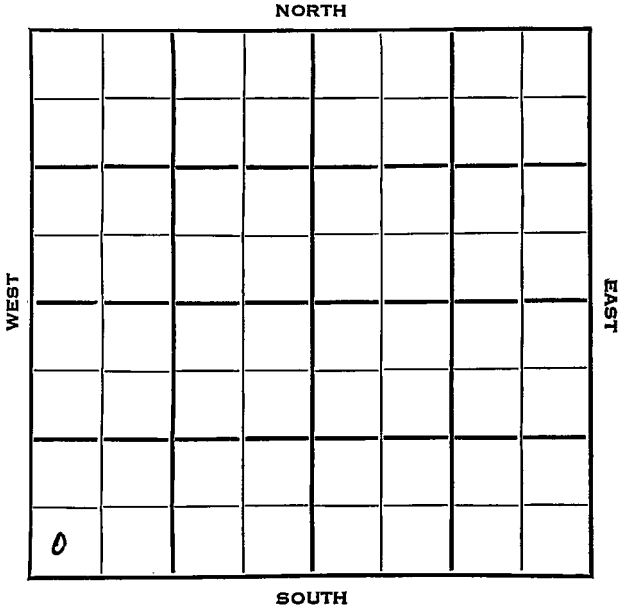

Logan. KANSAS

SEC.	TWP.	R.
11	14	34W ✓

WELL NO.

1 Newcomb FARM

COMPANY

Gerald Gordon & Wycoff

CONTRACTOR

Wildcat


Ft. from N. Line

330 Ft. from S. Line

Ft. from E. Line

330 Ft. from W. Line

SW SW SW

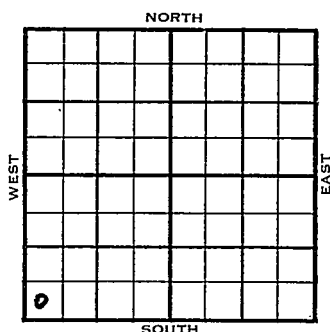

	ELEVATION	REPORT
1954	-	

3/10 Spud 3-6-54
 Drlg. 300'
 3/17 Spud 3-6-54
 Line 643', Codell 900'
 TD 965'
 D&A

ABANDONED

J. G. McGEHEE

County Logan State Kansas
 Sec. 11 (Blk.) 14 (Sur.) 34W Map No.

Operator Gerald Gordon & Wycoff

Well No. 1 Farm Newcomb

Elev. Location SW SW SW



330 Ft. From S Line SW

330 Ft. From W Line Quarter

1st. Report

Completion MAR 17 1954

Remarks Wildcat

Spudding Date 3-6-54

Drlg. Data

lime 643 Code 11 900 TD 965

D & A