


Section 11 Township 14 Range 15W
Well No. 3 Cramm
Company J. C. Shaffer

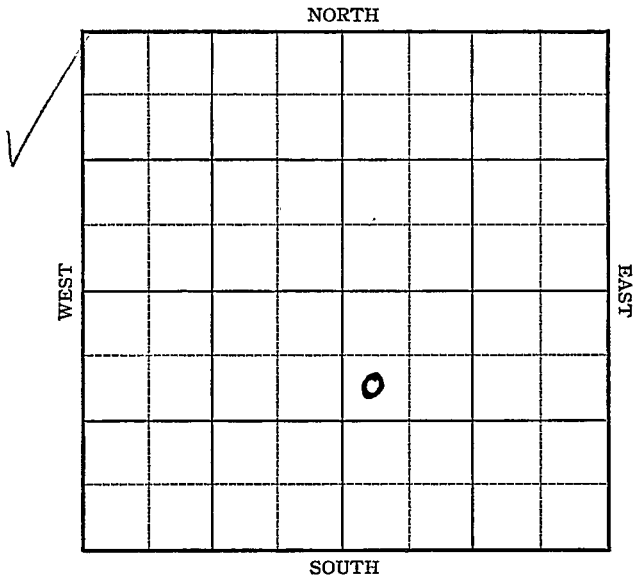

Sec. 11 Twp. 14 R. 15-W

Well No. #3 Cramm Farm
J. C. Shaffer Company


990 Ft. from N. Line

_____ Ft. from S. Line

_____ Ft. from E. Line

330 Ft. from W. Line

Elev. 1863

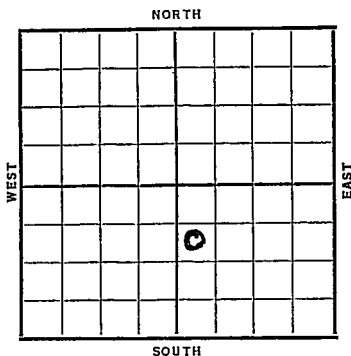

Date	REPORT
1937	
10/6	Cellar.
10/15	B.R.R.
10/22	10" @ 608'. WOC.
10/29	Drlg. 2625'.
11/5	K.C. 3026'. T.D. 3054'.
	Sat. core. 7" @ 3026'.
11/12	Drlg. 3057'.
11/19	Drlg. 3205'.
11/26	Gorham 3265 & 5".
	T.D. 3269'. 2500' oil.
12/1	5" @ 3265'.
	Gorham 3265'.
	T.D. 3269'.
	Potential 598½ bbls.
	COMPLETED

Map No. _____ Sec. 11 Twp. 14 R. 15WWell No. 3 CrammJ C Shaffer

Company _____

Contractor _____

FIRST REPORT**SECTION PLAT**

SW NW SE

990 Ft. from N. Line

_____ Ft. from S. Line

_____ Ft. from E. Line

330 Ft. from W. Line

		0	

Location _____

Rig up _____

Drilling and Remarks:

Cellar**RECORD**

Cased _____ in., _____ ft.

Sand _____

Gas _____

Oil _____

Total Depth _____

PRODUCTION

1st 24 hrs. Nat. _____

1st 24 hrs. after shot _____

Gas _____ Cu. Ft.

Dry Hole _____

Abandoned _____

Date

Oct - 6 1937H. D. Hatfield19

Scout

Russell **KANSAS**

Map No. 72 Sec. 11 Twp. 14 R. 15W

Well No. 3 Cramm

J. C. Shaffer Company

Contractor

COMPLETED

SW NW SE

990 Ft. from N. Line

_____ Ft. from S. Line

_____ Ft. from E. Line

330 Ft. from W. Line

SECTION PLAT

		0	

Location _____

Rig up _____

Drilling and Remarks:

POT - 598 1/2

RECORD

Cased 5 in., 3265 ft.

Sand Gorham 3265

Gas _____

Oil _____

Total Depth 3269

PRODUCTION

1st 24 hrs. Nat. _____

1st 24 hrs. after shot _____

Gas _____ Cu. Ft.

Dry Hole _____

Abandoned _____

Date

DEC 1 - 1937

19

H. D. Hatfield Scout