


Russell KANSAS

Section 11 Township 14 Range 15-W

Well Number 2 "B" Dumbler

Company Darby

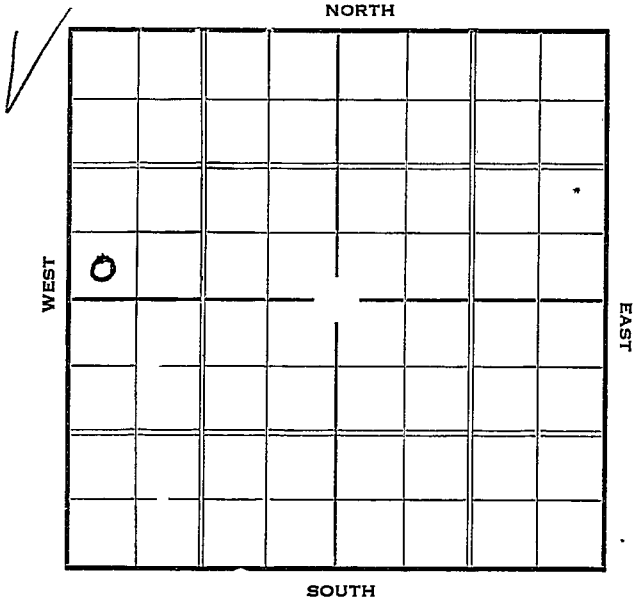

KANSAS Russell

Map No. _____ Sec. 11 Twp. 14 R. 15-W

Well No. #2 "B" Dumbler Farm _____


Darby Company _____

_____ Ft. from N. Line

330 Ft. from S. Line

_____ Ft. from E. Line

330 Ft. from W. Line

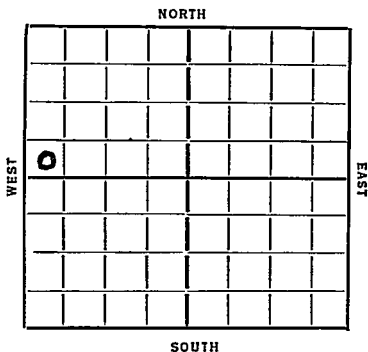

Date	REPORT
1935	
12/22	Rig
12/29	Rigging up.
1937	
1/7	Drlg. 575'.
1/14	10" @ 886'. Anhydrate 891'.
	Drlg. 1270'.
1/21	Drlg. 2260'.
1/28	8" @ 2530'. Drlg. 2560'.
2/4	KCL 3025' Show Oil 3052, 6" @ 3181'
	Drlg.
2/11	Gorham 3266 Set 7" WOC
2/17	Gorham sand 3266'.
	T. D. 3274'.
	Potential 584 natural.
	COMPLETED

KANSAS

Map No. 72 Sec. 11 Twp. 14 R. 15W

Well No. 2 "B" Hunter

Harty. Company

Contractor

SECTION PLAT

0			

_____ Ft. from N. Line

330 Ft. from S. Line

_____ Ft. from E. Line

330 Ft. from W. Line

FIRST REPORT

Location _____

Rig up _____

Drilling and Remarks:

Rig

RECORD

Cased _____ in., _____ ft.

Sand _____

Gas _____

Oil _____

Total Depth _____

PRODUCTION

1st 24 hrs. Nat. _____

1st 24 hrs. after shot _____

Gas _____ Cu. Ft.

Dry Hole _____

Abandoned _____

Date

DEC 22 1936

19

S. J. LEWIS

Scout

