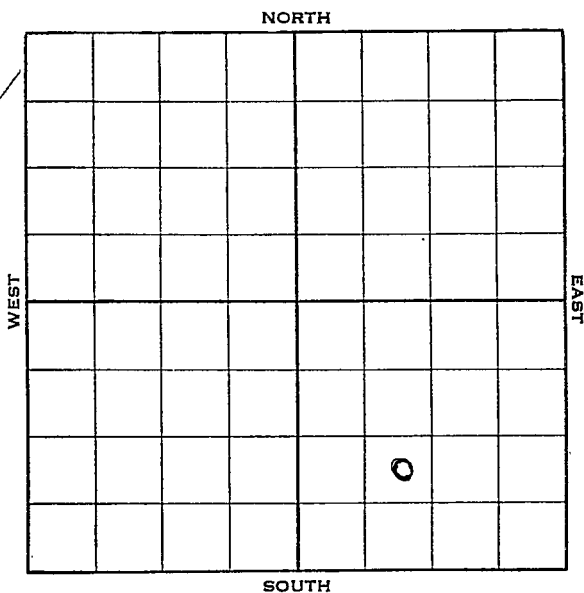


Russell


Section 11 Township 14 Range 15-WWell No. 3 CrammCompany Transwestern

KANSAS

Russell

Sec. 11 Twp. 14 R. 15 ~~W~~Well No. #3 Cramm Farm
Transwestern Company Ft. from N. Line990 Ft. from S. Line Ft. from E. Line990 Ft. from W. Line

Elev. 1866'.

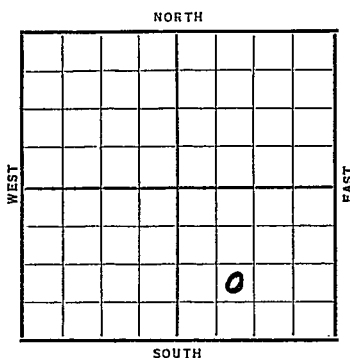

Date	REPORT
1938	
2/2	B.R.R.
2/11	10" @ 600'. WOC.
2/18	Drlg. 2150'.
2/26	Lans. 3040'. Coring 3067'.
	Sm. S.O.
3/4	Arb. 3272'. 7" @ 3273'.
	T.D. 3274'. RUST.
	No shows reported.
3/9	7" @ 3273'.
	Arb. 3272'.
	T.D. 3279'.
	3000 acid.
	Potential 890 oil & 141 water.
	COMPLETED

Russell KANSAS

Map No. 72 Sec. 11 Twp. 14 R. 15WWell No. 3 CrammTranswestern CompanyFIRST REPORT Contractor

SECTION PLAT

NE SW SE

 Ft. from N. Line990 Ft. from S. Line Ft. from E. Line990 Ft. from W. Line

		0	

Location Rig up

Drilling and Remarks:

BRR

RECORD

Cased in., ft.Sand Gas Oil Total Depth

PRODUCTION

1st 24 hrs. Nat. 1st 24 hrs. after shot Gas Cu. Ft.Dry Hole Abandoned

Date

FEB 2 1938 19

H. D. Hatfield Scout

Russell

KANSAS

Map No. _____ Sec. 11 Twp. 14 R. 15WWell No. 3 CrammTranswestern

Company

Contractor

COMPLETED

NE SW SE

_____ Ft. from N. Line

990 Ft. from S. Line

_____ Ft. from E. Line

990 Ft. from W. Line

SECTION PLAT

		0	

Location _____

Rig up _____

Drilling and Remarks:

*3000 acid**POT 890**141 WTS*

RECORD

Cased 7 in. 3273 ft.Sand Arb 3272

Gas _____

Oil _____

Total Depth 3279

PRODUCTION

1st 24 hrs: Nat. _____

1st 24 hrs. after shot _____

Gas _____ Cu. Ft.

Dry Hole _____

Abandoned _____

Date

MAR 9 - 1938

19

H. D. Hatfield Scout