

Russell

KANSAS


Form 51-5M 5-37 Petrol

Section 11 Township 14 Range 15-W

Well No. 1 Cramm

Company Transwestern

NORTH

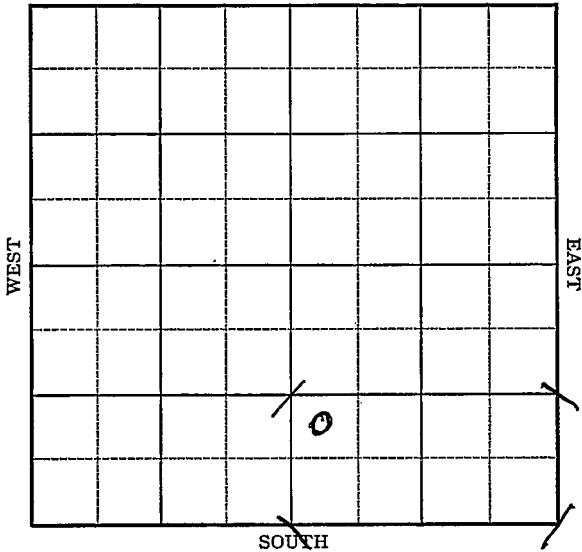

SOUTH

WEST

EAST

Sec. 11 Twp. 14 R. 15-W

Well No. #1 Cramm Farm

Transwestern Company


         Ft. from N. Line

990 Ft. from S. Line

         Ft. from E. Line

330 Ft. from W. Line

Elev. 1842

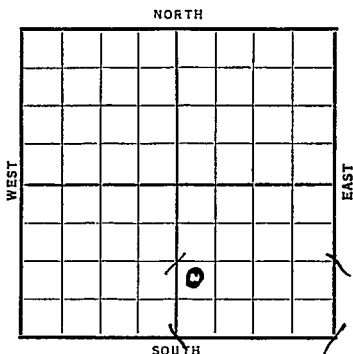

Date	REPORT
1937	
11/23	Cellar.
12/3	T.D. 600'. Rng. pipe.
12/10	10" @ 600'. Drlg. 2010'.
12/17	Drlg. 3145'.
12/24	7" @ 3245'. WOC.
12/31	" " "
1938	
1/7	Gorham 3253'. T.D. 3258'.
	2250' oil.
1/14	" " "
1/19	7" @ 3245'.
	Gorham 3253'.
	T.D. 3258'.
	Potential 432 bbls.
	<b>COMPLETED</b>

Map No. 72 Sec. 11 Twp. 14 R. 15WWell No. 1 CrammTranswestern

Company

Contractor

## FIRST REPORT

NW SW SE

\_\_\_\_\_ Ft. from N. Line

990 Ft. from S. Line

\_\_\_\_\_ Ft. from E. Line

330 Ft. from W. Line

## SECTION PLAT

		o	

Location \_\_\_\_\_

Rig up \_\_\_\_\_

Drilling and Remarks:

**Cellar**

## RECORD

Cased \_\_\_\_\_ in., \_\_\_\_\_ ft.

Sand \_\_\_\_\_

Gas \_\_\_\_\_

Oil \_\_\_\_\_

Total Depth \_\_\_\_\_

## PRODUCTION

1st 24 hrs. Nat. \_\_\_\_\_

1st 24 hrs. after shot \_\_\_\_\_

Gas \_\_\_\_\_ Cu. Ft.

Dry Hole \_\_\_\_\_

Abandoned \_\_\_\_\_

Date

NOV 23 1937 19H. D. Hatfield Scout

Russell KANSAS

Map No. 72 Sec. 11 Twp. 14 R. 15W

Well No. 1 Cramm

Transwestern Company

Contractor

**COMPLETED**

NW SW SE

**SECTION PLAT**

\_\_\_\_\_ Ft. from N. Line

990 Ft. from S. Line

\_\_\_\_\_ Ft. from E. Line

330 Ft. from W. Line

		0	

Location \_\_\_\_\_

Rig up \_\_\_\_\_

Drilling and Remarks:

*Pot 432*

**RECORD**

Cased 7 in. 3245 ft.

Sand Gorham 3253

Gas \_\_\_\_\_

Oil \_\_\_\_\_

Total Depth 3258

**PRODUCTION**

1st 24 hrs. Nat. \_\_\_\_\_

1st 24 hrs. after shot \_\_\_\_\_

Gas \_\_\_\_\_ Cu. Ft.

Dry Hole \_\_\_\_\_

Abandoned \_\_\_\_\_

Date

JAN 19 1939

H. D. Hatfield Scout