


Section 11 Township 14 Range 15-W

Well No. 4 Cramm

Company Shaffer

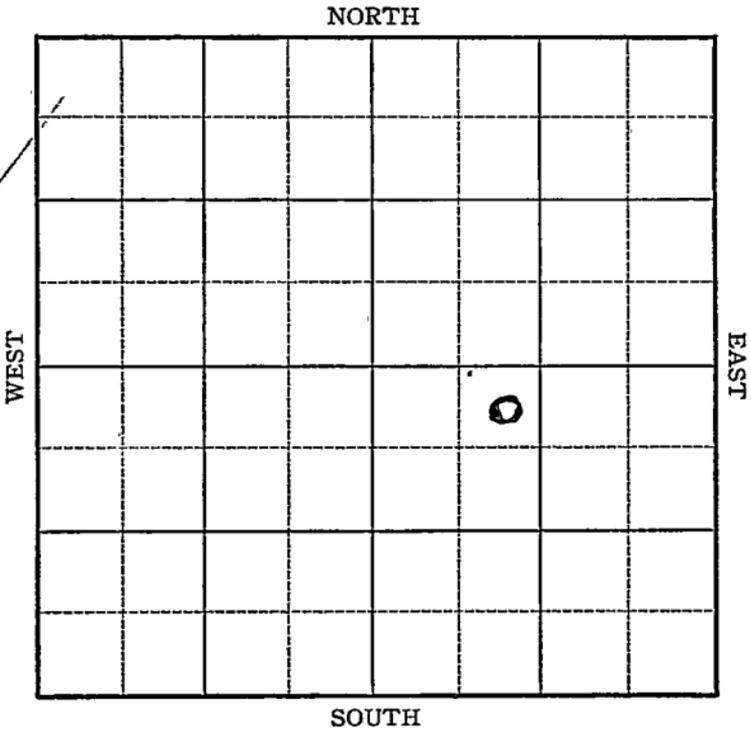

Sec. 11 Twp. 14 R. 15-W

Well No. #4 Cramm Farm
Shaffer Company


330 Ft. from N. Line

_____ Ft. from S. Line

_____ Ft. from E. Line

990 Ft. from W. Line

Elev. 1872

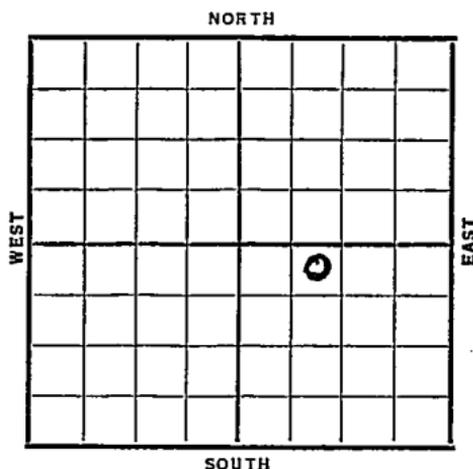

Date	REPORT
1937	
11/3	R U R
11/12	10" @ 600'. WOC.
11/19	K.C. 3030'. T.D. 3032'. Rng. 7".
11/26	7" @ 3032' SD.
12/3	Pay 3057-76' T.D. 500' oil 14 hrs.
12/8	7" @ 3032'.
	K.C. 3030'.
	T.D. 3076'.
	10,000 acid.
	Potential 1204 bbl s.
	COMPLETED

Russell KANSAS

Map No. _____ Sec. 11 Twp. 14 R15W

Well No. 4 Cramm

Shaffer

Company

~~FIRST REPORT~~

Contractor

SECTION PLAT

NE NW SE

330 Ft. from N. Line

_____ Ft. from S. Line

_____ Ft. from E. Line

990 Ft. from W. Line

		0	

Location _____

Rig up _____

Drilling and Remarks:

RUR

RECORD

Cased _____ in., _____ ft.

Sand _____

Gas _____

Oil _____

Total Depth _____

PRODUCTION

1st 24 hrs. Nat. _____

1st 24 hrs. after shot _____

Gas _____ Cu. Ft.

Dry Hole _____

Abandoned _____

Date

NOV 3 1937

19

H. D. Hatfield

Scout

Russell **KANSAS**

Map No. _____ Sec. 11 Twp. 14 R. 15W

Well No. 4 Cramm

Shaffer Company

Contractor

COMPLETED

NE NW SE

330 Ft. from N. Line

_____ Ft. from S. Line

_____ Ft. from E. Line

990 Ft. from W. Line

SECTION PLAT

		0	

Location _____

Rig up _____

Drilling and Remarks:

10,000 acid

PT-1204

RECORD

Cased 7 in., 3032 ft.

Sand A.P. 3030

Gas _____

Oil _____

Total Depth 3076

PRODUCTION

1st 24 hrs. Nat. _____

1st 24 hrs. after shot _____

Gas _____ Cu. Ft.

Dry Hole _____

Abandoned _____

Date

DEC 8 - 1937 19

H. D. Hatfield

Scout