


Russell

Map No. _____ Sec. 11 Twp. 14 R. 15^w

Well No. 3- Hunter Farm _____
Harby Pet Company _____

990 Ft. from N. Line
____ Ft. from S. Line
____ Ft. from E. Line
330 Ft. from W. Line

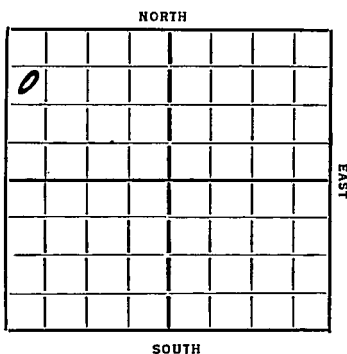

Elev. 1863

REPORT

1936	
3/18	Location
3/20	--
3/27	Rig on ground.
4/2	B.R.
4/10	Rigging up.
4/16	Drlg. 475'
4/23	15" @ 532' - Drlg. 790'
4/30	Drlg. 1935'
5/7	Drlg. 2625'.
5/14	Lansing 3035'. Drlg. 3115'.
5/21	6" @ 3272'. Drlg.
5/28	Gorham 3279 $\frac{1}{2}$ -3287'. 2700' oil.
6/4	Testing.
6/11	Pump 365 bbls oil and 147 bbls water in 9 hours.
6/17	/36-Regan Sand 3279 $\frac{1}{2}$ '.
	T.D. 3287'.
	624 bbls oil and 400 bbls water
	COMPLETED

Map No. 72 Sec. 11 Twp. 14 R. 15N

Well No. 3 - Dumber

Harby Pet Company

Contractor

FIRST REPORT

SECTION PLAT

990 Ft. from N. Line

..... Ft. from S. Line

..... Ft. from E. Line

330 Ft. from W. Line

0			

Location *↙*.....
 Rig up.....
 Drilling and Remarks:

RECORD

Cased..... in., ft.
 Sand.....
 Gas.....
 Oil.....
 Total Depth.....

PRODUCTION

1st 24 hrs. Nat.....
 1st 24 hrs. after shot.....
 Gas..... Cu. Ft.
 Dry Hole.....
 Abandoned.....

Date

3-18-36 192.....

ORVAL MANNSCHRECK

Scout

Russell

Map No. 72 Sec. 11 Twp. 14 R. 15W

Well No. 3 Dumbler

Darty Company

Contractor

SECTION PLAT

0			

990 Ft. from N. Line

_____ Ft. from S. Line

_____ Ft. from E. Line

330 Ft. from W. Line

COMPLETED

Location _____

Rig up _____

Drilling and Remarks:

Re gased 3279 1/2
624 oil
400 water

RECORD

Cased _____ ft.

Sand _____

Gas _____

Oil _____

Total Depth 3287

PRODUCTION

1st 24 hrs. Nat. _____

1st 24 hrs. after shot _____

Gas _____ Cu. Ft.

Dry Hole _____

Abandoned _____

Date

JUN 17 1936

19

S. J. LEWIS

Scout