

Russell ^{KANSAS} 15W

Section 11 Township 14 Range 15W

Well No. #6 Dumler "A"

Company Sunray

NORTH

			0						

WEST

EAST

SOUTH



Russell

KANSAS

Sec. 11 Twp. 14 R. 15W ✓

Well No. #6 Dunler "A" Farm

Sunray Company

Stickle Drlg. - Contr. Contractor


990' Ft. from N. Line

_____ Ft. from S. Line

330' Ft. from E. Line

_____ Ft. from W. Line

SE NE NW

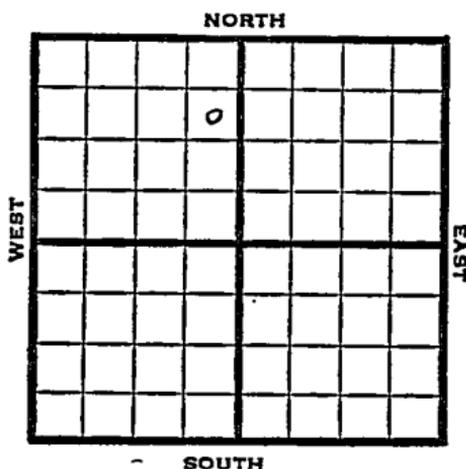

1950

Elev 1867' REPORT

11/22

Spud 11-18-50
8" @ 922'

12/20

8" @ 922
Heeb 2978 Lans 3033
DST 3052-75 opn 1 hr rec 30' mdd & wtr
Arb 3281-84
5" @ 3282
TD 3284
FU 1300' oil 12 hr
Comp 75 bopd
Completed

COMPLETED

County Russell State Kansas

Sec. 11 (Blk. Twp.) 14 (Sur. Rge.) 15W Map No.

Operator Sunray

Well No. 6 Farm Dumler "A"

Elev. 1867 Location SE NE NW

		0			

990 Ft. From N Line NW

330 Ft. From E Line Quarter

1st. Report NOV 22 1950

Completion _____

Remarks _____

Stickle Drlg. - Contr.

Spudding Date 11-18-50

Drlg. Data _____

8" @ 922

J. E. TYRA

County Russell State Kansas

Sec. 11 (Blk. Twp.) 14 (Sur. Rge.) 15W Map No.

Operator Sunray

Well No. 6 Farm Dumler "A"

Elev. 1867 Location SE NE NW

990 Ft. From N Line NW

330 Ft. From E Line Quarter

1st. Report

Completion DEC 20 1950

Remarks

Stickle Drlg. - Contr.

Spudding Date 11-18-50

Drlg. Data Oil well TD 3284

8" @ 922 Heeb. 2978 Lans. 3063

DST 3052-75 open 1 hr. Rec. 30' mud & water

Arb. 3281-84 5" @ 3282 TD 3284

FU 1300' oil 12 hr. Comp. 75 bond