


Section 11 Township 14 Range 15-W

Well No. 5 Cramm

Company J. C. Shaffer

NORTH

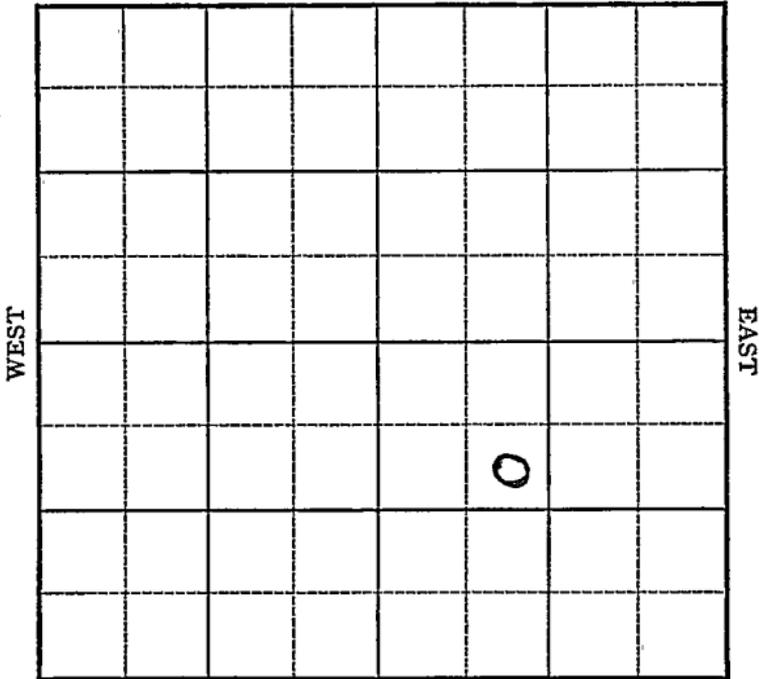

SOUTH

Sec. 11 Twp. 14 R. 15 ~~W~~

Well No. #5 Cramm Farm


J. C. Shaffer Company

990 Ft. from N. Line

_____ Ft. from S. Line

_____ Ft. from E. Line

990 Ft. from W. Line

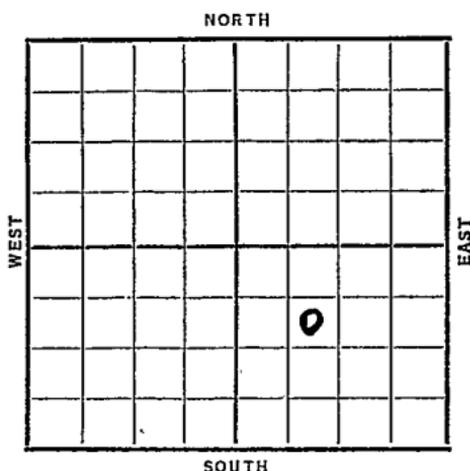

Date	REPORT
1938	
1/5	S. H.
1/14	10" @ 620'. Drlg. 1885'.
1/20	Lansing 3027?
	7" - 3032' R.U.S.T.
1/28	TD. 3070' 12,000 acid
	Pump 111 bbls oil in 4 hrs
	on Pot.
2/2	7" @ 3032'.
	Lans. 3027'.
	T.D. 3070'.
	12,000 acid.
	Potential 789 bbls.

COMPLETED

Map No. 72 Sec. 11 Twp. 14 R. 15WWell No. 5 CrammJ. C. Shaffer

Company

Contractor

FIRST REPORT

SECTION PLAT

SE NW SE

990 Ft. from N. Line

_____ Ft. from S. Line

_____ Ft. from E. Line

990 Ft. from W. Line

		0	

Location _____

Rig up _____

Drilling and Remarks:

SH

RECORD

Cased _____ in., _____ ft.

Sand _____

Gas _____

Oil _____

Total Depth _____

PRODUCTION

1st 24 hrs. Nat. _____

1st 24 hrs. after shot _____

Gas _____ Gu. Ft.

Dry Hole _____

Abandoned _____

Date

JAN 5 - 1938 19

H. D. Hatfield Scout

Map No. _____ Sec. 11 Twp. 14 R. 15WWell No. 5 Cramm_____J. C. Shaffer_____
Company_____
Contractor**COMPLETED****SE NW SE**990 Ft. from N. Line

____ Ft. from S. Line

____ Ft. from E. Line

990 Ft. from W. Line**SECTION PLAT**

		o	

Location _____

Rig up _____

Drilling and Remarks:-

*12,000 acid**pot - 789***RECORD**Cased 7 in., 3032 ft.Sand Lans 3047

Gas _____

Oil _____

Total Depth 3070**PRODUCTION**

1st 24 hrs. Nat. _____

1st 24 hrs. after shot _____

Gas _____ Cu. Ft.

Dry Hole _____

Abandoned _____

Date

FEB 2 1938 19 _____

E. D. Hatfield Scout