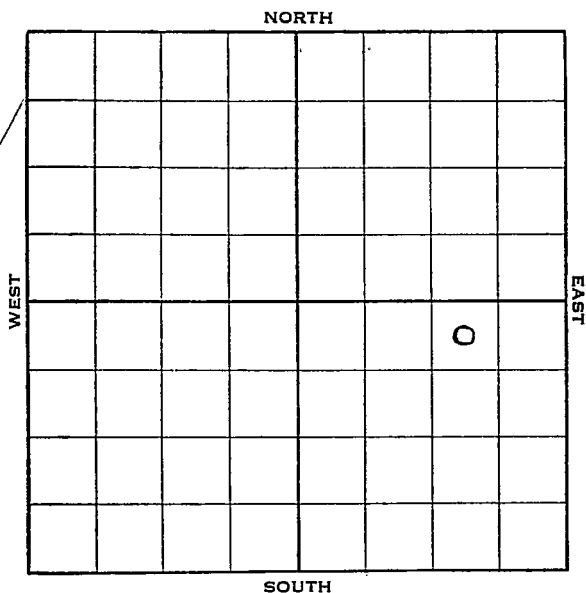


Section 11 Township 14 Range 15-WWell No. 6 CrammCompany J. C. Shaffer

Russell KANSAS

Map No. _____ Sec. 11 Twp. 14 R. 15WWell No. 6 CrammJ. C. Shaffer

Company

Contractor

FIRST REPORT

SECTION PLAT

NW NE SE

330 Ft. from N. Line

Ft. from S. Line

990 Ft. from E. Line

Ft. from W. Line

			0

Location _____

Rig up _____

Drilling and Remarks:

10" - 595Lans. 30357" & T.D. 3035RUST

RECORD

Cased _____ in., _____ ft.

Sand _____

Gas _____

Oil _____

Total Depth _____

PRODUCTION

1st 24 hrs. Nat. _____

1st 24 hrs. after shot _____

Gas _____ Cu. Ft.

Dry Hole _____

Abandoned _____

Date

FEB 16 1938H. D. Hatfield

Scout

Russell KANSAS

Map No. _____ Sec. 11 Twp. 14 R. 15WWell No. 6 CrammJ. C. Shaffer

Company

Contractor

COMPLETED

SECTION PLAT

NW NE SE

330 Ft. from N. Line

_____ Ft. from S. Line

990 Ft. from E. Line

_____ Ft. from W. Line

			0

Location _____

Rig up _____

Drilling and Remarks:

5000 acidPOT 613

RECORD

Cased 7 in., 3035 ft.Sand Lens 3028

Gas _____

Oil _____

Total Depth 3075

PRODUCTION

1st 24 hrs. Nat. _____

1st 24 hrs. after shot _____

Gas _____ Cu. Ft.

Dry Hole _____

Abandoned _____

Date

MAR 9 - 1938

19

H. D. Hatfield

Scout