


Section 11 Township 14 Range 15W

Well Number #4 Dumbler

Company Darby

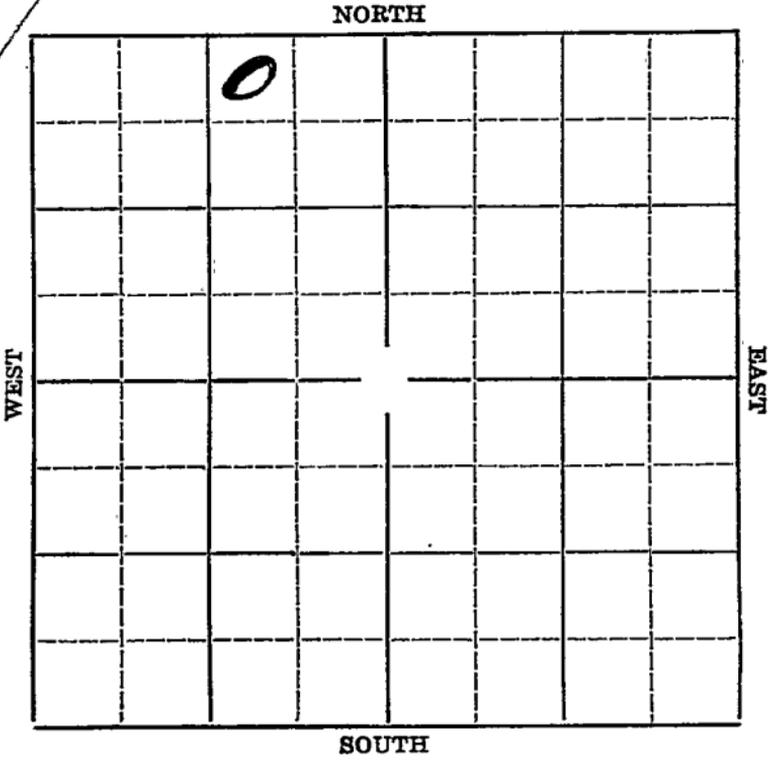

Map No. KANSAS Sec. 11 Twp. 14 R. 15W


Well No. #4 Dumbler Farm  
Darby Company

330' Ft. from N. Line

\_\_\_\_\_ Ft. from S. Line

990' Ft. from E. Line

\_\_\_\_\_ Ft. from W. Line

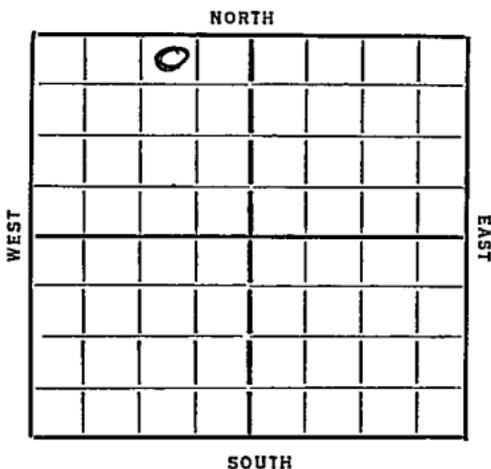

Date: 1936

REPORT

- 6/3 Location.
- 6/11 Rigging up.
- 6/18 Drlg. 385'.
- 6/25 Drlg. 555'.
- 7/2 Anhy. 910'. Drlg. 1425'.
- 7/9 Drlg. 2460'.
- 7/16 8" @ 2560'. Lansing 3052'. Dlg. 3061'.
- 7/23 6" @ 3242'. T.D. 3280'. Under ream 6".
- 7/30 Gorham 3290'. Show oil 3292-94'. Total depth 3295'-600' oil 1 hour.
- 8/6 2000' of oil.
- 8/13 No test.
- 8/19/36-Gorham 3290'. T.D. 3295'. Potential 278 bbls of oil.

COMPLETED

KANSAS

Map No. 72 Sec. 11 Twp. 14 R. 15WWell No. 4 Dumbler

Company

Contractor

## SECTION PLAT

	0		

320 Ft. from N. Line

\_\_\_\_\_ Ft. from S. Line

990 Ft. from E. Line

\_\_\_\_\_ Ft. from W. Line

## FIRST REPORT

Location ✓

Rig up \_\_\_\_\_

Drilling and Remarks:

## RECORD

Cased \_\_\_\_\_ in., \_\_\_\_\_ ft.

Sand \_\_\_\_\_

Gas \_\_\_\_\_

Oil \_\_\_\_\_

Total Depth \_\_\_\_\_

## PRODUCTION

1st 24 hrs. Nat. \_\_\_\_\_

1st 24 hrs. after shot \_\_\_\_\_

Gas \_\_\_\_\_ Cu. Ft.

Dry Hole \_\_\_\_\_

Abandoned \_\_\_\_\_

Date

JUN 3 1936 19

S. J. LEWIS

Scout

Map No. 72 Sec. 11 Twp. 14 R. 15W.

Well No. 4. Tumbler.

Tardy. Company

Contractor

SECTION PLAT

	0		

330 Ft. from N. Line

\_\_\_\_\_ Ft. from S. Line

990 Ft. from E. Line

\_\_\_\_\_ Ft. from W. Line

COMPLETED

Location \_\_\_\_\_

Rig up \_\_\_\_\_

Drilling and Remarks:

Got ham 3290

Pa 278

RECORD

Cased \_\_\_\_\_ in., \_\_\_\_\_ ft.

Sand \_\_\_\_\_

Gas \_\_\_\_\_

Oil \_\_\_\_\_

Total Depth 3295

PRODUCTION

1st 24 hrs. Nat. \_\_\_\_\_

1st 24 hrs. after shot. \_\_\_\_\_

Gas \_\_\_\_\_ Cu. Ft.

Dry Hole \_\_\_\_\_

Abandoned \_\_\_\_\_

Date

AUG 19 1936<sup>19</sup>

S. J. LEWIS Scout