
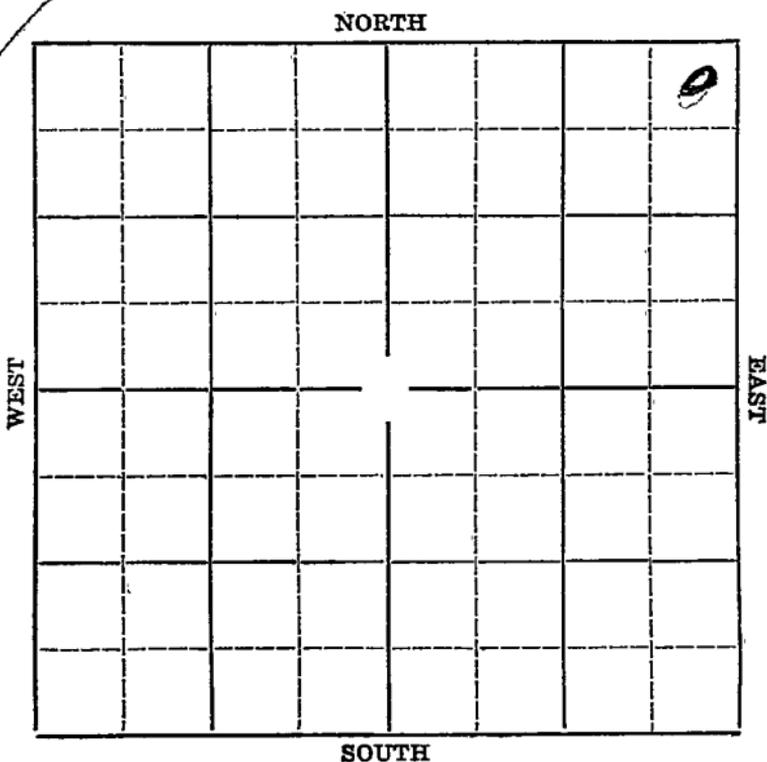


Section 11 Township 14 Range 15-W

Well Number #1 Dumbler "C"

Company Darby Pet.

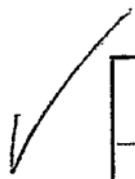

Sec. 11 Twp. 14 R. 15W

Well No. #1 Dumbler "G" Farm _____
Darby Petroleum. Company _____


330' Ft. from N. Line

_____ Ft. from S. Line

330' Ft. from E. Line

_____ Ft. from W. Line


Elev 1883

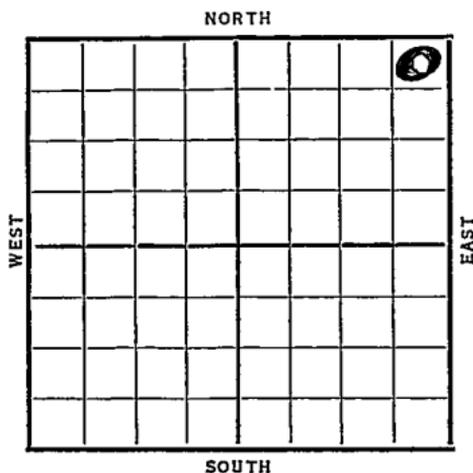

Date	REPORT
10/7	Rig on ground.
10/15	Rigging up.
10/22	12" @ 533'. Waiting on cement.
10/29	Anhydrate 903'. 10" @ 909'. Drlg. 1040'.
11/6	Drlg. 2215
11/12	8" @ 2529 Oswald 3055 Drlg. 3062
11/19	6" @ 3297'. Sil. 3302'. Oil 3308'. Drlg. 3314'.
11/27	T. D. 3329'. Hole full water. Will plug back.
12/3	P.B. 3311'. 20 shots. 3000 acid. No test.
12/9	Sil. 3302 P.B. 3311 20 shots Lane Gun 3000 acid T.D. 3329 D&A
ABANDONED	

Russell
 Map No. 72 Sec. 11 Twp. 14 R. 15W.
 Well No. 1 *Transter "C"* Farm
Tarby Pet. Company
 Date Started Ft. from N334S. E330W. line

NORTH

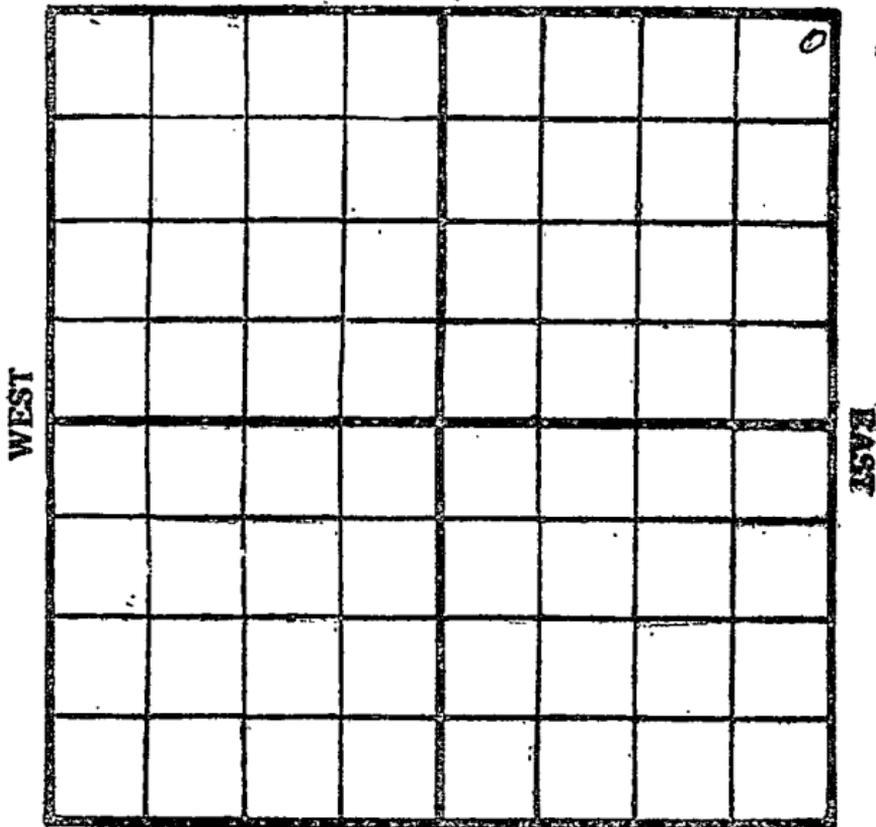

SOUTH

Cased _____ In. _____ Ft.
 Sand _____
 Pay { Gas _____
 Oil _____
 Total Depth _____

Production Remarks
RCG

Condition of Well on this date _____

FIRST REPORT

OCT 7 1936

S. J. LEWIS Scout

KANSAS

Map No. 72 Sec. 11 Twp. 14 R. 15W

Well No. 1. Hunter "C"

Harty P. & Co. Company

[Signature] Contractor

SECTION PLAT

			2

330 Ft. from N. Line

_____ Ft. from S. Line

330 Ft. from E. Line

_____ Ft. from W. Line

ABANDONED

Location _____

Rig up _____

Drilling and Remarks:

Oil 3302.
P.B 3311
20 Skd to Lane gun
3000 acid
D & H

RECORD

Cased _____ in., _____ ft.

Sand _____

Gas _____

Oil _____

Total Depth 3329

PRODUCTION

1st 24 hrs. Nat. _____

1st 24 hrs. after shot _____

Gas _____ Cu. Ft.

Dry Hole _____

Abandoned _____

Date

DEC 9 1936 19

S. J. LEWIS

Scout