


RUSSELL

Form 51-5M-3-35-Mid-West

Map No. KANSAS Sec. 11 Twp. 14 R. 15-W

Well No. 2-Dumler Farm
Darby Pet. Company

NORTH

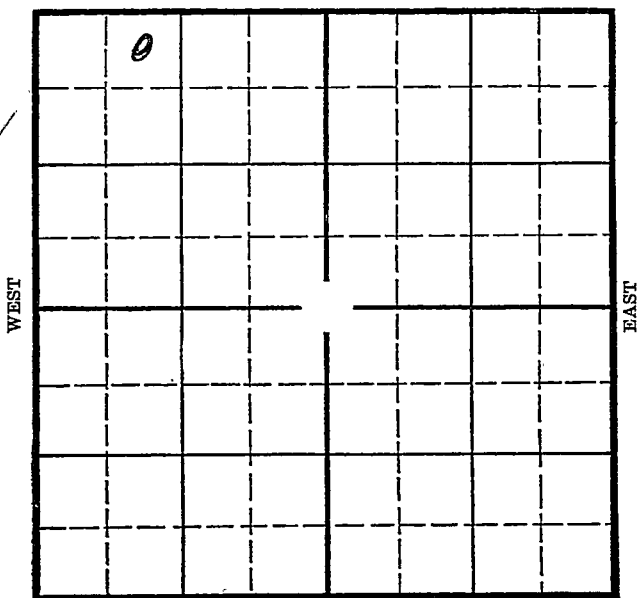

SOUTH

Location _____

Drilling Remarks _____

Rig Up _____

Drilling Remarks _____

RECORD

Cased _____ in. _____ ft.

Sand _____

Gas _____

Oil _____

Total Depth _____

PRODUCTION

1st 24 hrs. Nat. _____

1st 24 hrs. after shot _____

Gas _____ cu. ft. _____

Dry Hole _____

Abandoned _____

3M 7-35 MFC
KANSAS
Map No. _____ Sec. 11 Twp. 14 R. 15W
Well No. 2- Number Farm _____
Darby Pet Company _____
NORTH

330 Ft. from N. Line

Ft. from S. Line

Ft. from E. Line

990 Ft. from W. Line

Elev. 1876

NORTH

SOUTH

REPORT

DATE	REPORT
3/18	Location
3/20	--
3/27	B.R.
4/2	Rign.
4/10	Drlg. 260'
4/16	Drlg. 630'
4/23	Drlg. 919'
4/30	Drlg. 2080'
5/7	Drlg. 2536'.
5/14	Lansing 3040'-6" @ 3056' Drlg. 3100'.
5/21	3280' U.R. 6".
5/28	3287-90' 2,700' of Oil.
	GORHAM 3287-90' 2,700' of Oil.
6/3/36	Gorham 3287'. T.D. 3290'. Pot. 802 bbls nat.

COMPLETED

Map No. 72 Sec. 11 Twp. 14 R. 15WWell No. 2-DumlerDarby Pit Company

Contractor

FIRST REPORT

SECTION PLAT

330 Ft. from N. Line

Ft. from S. Line

Ft. from E. Line

990 Ft. from W. Line

0			

Location ☒

Rig up

Drilling and Remarks:

RECORD

Cased _____ in., _____ ft.

Sand _____

Gas _____

Oil _____

Total Depth _____

PRODUCTION

1st 24 hrs. Nat. _____

1st 24 hrs. after shot _____

Gas _____ Cu. Ft.

Dry Hole _____

Abandoned _____

Date

3-18-36 192 ORVAL MANNSCHRECK Scout

Map No. 72 Sec. 11 Twp. 14 R. 15WWell No. 2 Hunter

Company

Contractor

SECTION PLAT

o			

320 Ft. from N. Line

_____ Ft. from S. Line

_____ Ft. from E. Line

990 Ft. from W. Line

COMPLETED

Location _____

Rig up _____

Drilling and Remarks:

Gorkan 3287Port 802 Nat.

RECORD

Cased _____ in., _____ ft.

Sand _____

Gas _____

Oil _____

Total Depth 3290

PRODUCTION

1st 24 hrs. Nat. _____

1st 24 hrs. after shot _____

Gas _____ Cu. Ft.

Dry Hole _____

Abandoned _____

Date

JUN 3 193 19S. J. LEWIS Scout