


Section 11 Township 14 Range 15-W

Well No. #6 Dumlér (B)

Company Sunray

NORTH

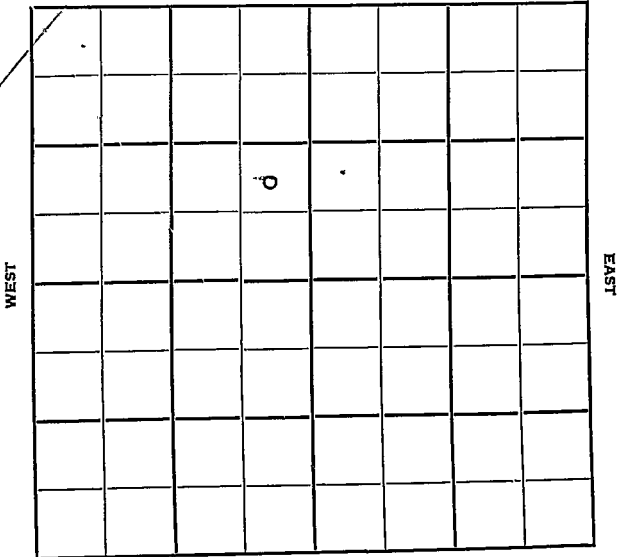

SOUTH

WEST

EAST

C

Sec. 11 Twp. 14 R. 15W *1*

Well No. #6 Dunler "B" Farm

Sunray- Company

Stickle Drlg. Contractor


Gorham
Ft. from N. Line

990'
Ft. from S. Line

330'
Ft. from E. Line

Ft. from W. Line

NE SE NW

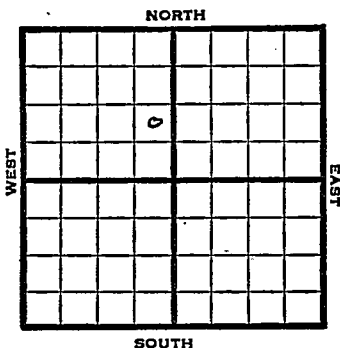

1950 Elev 1863 REPORT

5/31 Rig up
8/2 Anhy 890
8" @ 902
Tops 2723 Heeb 2974
Lans 3029
DST 3053-63, opn 1 hr rec 3' mud
DST 3063-3134 opn 1p hr rec 90' mud
Arb 3274-76
5" @ 3275 TD 3279 250A
S/25 boph 4 hr
Comp 200 bopd
Completed :

COMPLETED

Gorham

Form 26 200 Bks. 11-49 Petrol

Kansas

Map No. _____ Sec. 11 Twp. 14 R. 15W.

Well No. 6 Dumlér (R)

Sunray _____ Company

~~Stichde~~ *Stickle Drly.* _____ Contractor
NE SE NW

SECTION PLAT

_____ Ft. from N. Line

990 Ft. from S. Line

330 Ft. from E. Line

_____ Ft. from W. Line

	o		
FIRST REPORT			

Russell

Location _____

Rig up X

Drilling and Remarks:

RECORD

Cased _____ in., _____ ft.

Sand _____

Gas _____

Oil _____

Total Depth _____

PRODUCTION

1st 24 hrs. Nat. _____

1st 24 hrs. after shot _____

Gas _____ Cu. Ft.

Dry Hole _____

Abandoned _____

Date

MAY 31 1950 19

J. E. TYRA Scout

