


Section 11 Township 14 Range 15-W

Well Number 6 - W. Polcyn

Company Transwestern

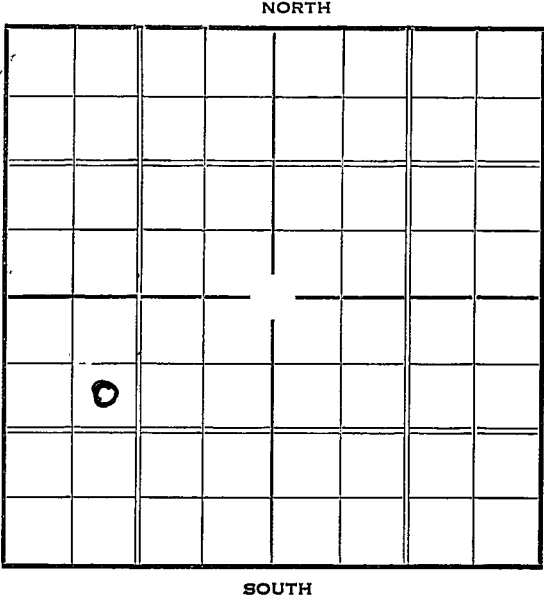

Sec. 11 Twp. 14 R. 15-W

Well No. #6 W. Polcyn Farm

Transwestern Company


990 Ft. from N. Line

_____ Ft. from S. Line

_____ Ft. from E. Line

990 Ft. from W. Line

Elev. 1859

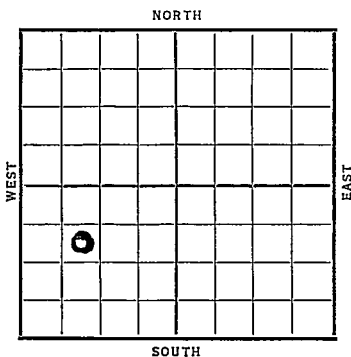

Date

REPORT

1937

5/12

Rigging up

5/21

10" @ 617'. Anhy 905'.

Drlg. 1415'.

5/28

Drlg. 2915'.

6/4

Gorham 3269'. T.D. 3273'.

7" @ 3260'.

6/9

7" @ 3260'.

Gorham 3269'.

T.D. 3273'.

Pot. 798 bbls.

COMPLETED

- Russell KANSAS

Map No. 72 Sec. 11 Twp. 14 R. 15^WWell No. 6 - W. PolaynTranswestern Company

Contractor

FIRST REPORT

SECTION PLAT

990 Ft. from N. Line

_____ Ft. from S. Line

_____ Ft. from E. Line

990 Ft. from W. Line

0			

Location _____

Rig up _____

Drilling and Remarks:

Rigging up

RECORD

Cased _____ in., _____ ft.

Sand _____

Gas _____

Oil _____

Total Depth _____

PRODUCTION

1st 24 hrs. Nat. _____

1st 24 hrs. after shot _____

Gas _____ Cu. Ft.

Dry Hole _____

Abandoned _____

Date

MAY 12 1937 19

H. D. Hatfield Scout

Russell KANSAS

Map No. 72 Sec. 11 Twp. 14 R. 15^WWell No. 6 - W PolcynTranswestern Company

Contractor

COMPLETED**SECTION PLAT**990 Ft. from N. Line

_____ Ft. from S. Line

_____ Ft. from E. Line

990 Ft. from W. Line

	0		

Location _____

Rig up _____

Drilling and Remarks:

RECORDCased 7 in. 3260 ft.Sand Corham 3269

Gas _____

Oil _____

Total Depth 3273**PRODUCTION**

1st 24 hrs. Nat. _____

1st 24 hrs. after shot _____

Gas _____ Cu. Ft.

Dry Hole _____

Abandoned _____

Pot - 798

Date

JUN 9 1937H. D. Hatfield

Scout