


Section 11 Township 14 Range 15-W

Well No. 9 - Wm. Polcyn

Company Transwestern

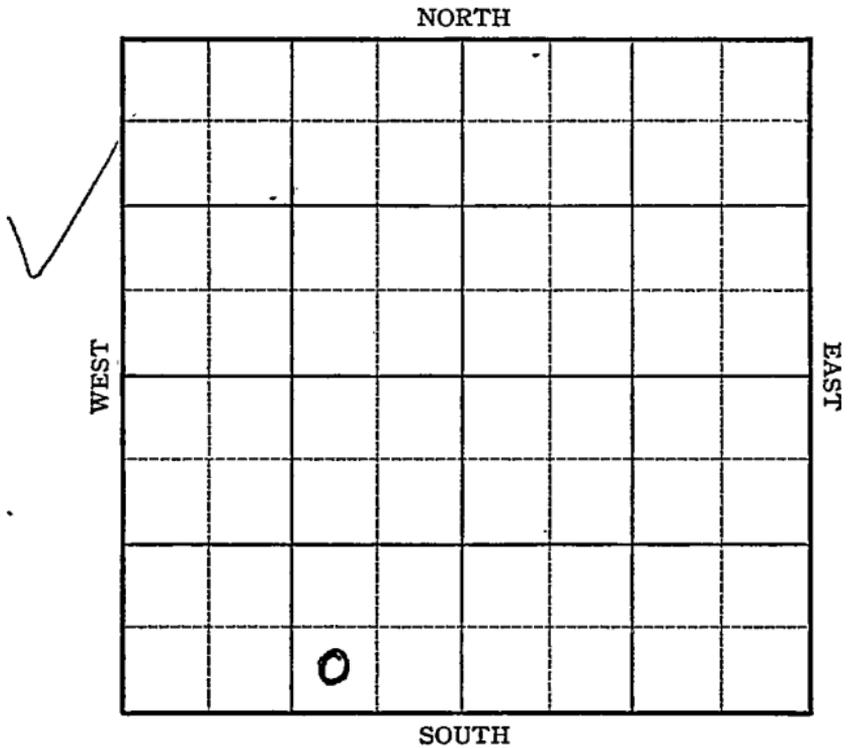

✓

Sec. 11 Twp. 14 R. 15-W

Well No. #9 Wm. Polcyn Farm

Transwestern Company


\_\_\_\_\_ Ft. from N. Line

330 Ft. from S. Line

990 Ft. from E. Line

\_\_\_\_\_ Ft. from W. Line

Elev. 1814

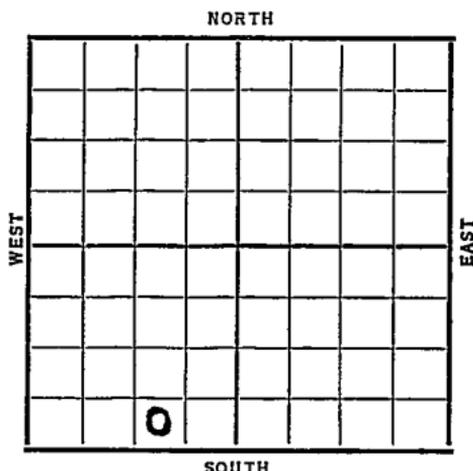

Date	REPORT
1937	
8/18	R. R.
8/28	S. H.
9/3	10" @ 590'. Drlg. 1997'.
9/10	Drlg. 3165'.
9/17	7" @ 3202'. WOC.
9/24	Gorh. 3216'. Pay 3219-21'.
	1500' oil 2 hrs.
9/29	7" @ 3202'.
	Gorham 3216'.
	T.D. 3221'.
	Pump 123 bbls. 4 hrs & 123 bbls.
	4 hrs.
	Pot. 739 bbls.
	<b>COMPLETED</b>

Russell **KANSAS**

Map No. \_\_\_\_\_ Sec. 11 Twp. 14 R. 15<sup>w</sup>

Well No. 9 - Wm. Polcyn

Transwestern Company

Contractor \_\_\_\_\_

**FIRST REPORT**

**SECTION PLAT**

\_\_\_\_\_ Ft. from N. Line

330 Ft. from S. Line

990 Ft. from E. Line

\_\_\_\_\_ Ft. from W. Line

	0		

Location \_\_\_\_\_

Rig up \_\_\_\_\_

Drilling and Remarks:

RR.

**RECORD**

Cased \_\_\_\_\_ in., \_\_\_\_\_ ft.

Sand \_\_\_\_\_

Gas \_\_\_\_\_

Oil \_\_\_\_\_

Total Depth \_\_\_\_\_

**PRODUCTION**

1st 24 hrs. Nat. \_\_\_\_\_

1st 24 hrs. after shot \_\_\_\_\_

Gas \_\_\_\_\_ Cu. Ft.

Dry Hole \_\_\_\_\_

Abandoned \_\_\_\_\_

Date

AUG 18 1937 19 \_\_\_\_\_

H. D. Hatfield Scout

Russell **KANSAS**

Map No. \_\_\_\_\_ Sec. 11 Twp. 14 R. 15W

Well No. 9-Wm Polcyn

Transwestern Company

Contractor \_\_\_\_\_

**COMPLETED**

SW SE SW

**SECTION PLAT**

\_\_\_\_\_ Ft. from N. Line

330 Ft. from S. Line

990 Ft. from E. Line

\_\_\_\_\_ Ft. from W. Line

	0		

Location \_\_\_\_\_

**RECORD**

Rig up \_\_\_\_\_

Cased 7 in. 3202 ft.

Drilling and Remarks:

Sand Gorham 3216

Gas \_\_\_\_\_

Oil \_\_\_\_\_

Total Depth 3221

*P. 123/4 123/4*

**PRODUCTION**

1st 24 hrs. Nat. \_\_\_\_\_

1st 24 hrs. after shot \_\_\_\_\_

Gas \_\_\_\_\_ Cu. Ft.

Dry Hole \_\_\_\_\_

Abandoned \_\_\_\_\_

*Pot. 739*

Date

SEP 20 1937