


Section 11 Township 14 Range 15-W  
Well No. 13 Wm. Polcyn  
Company Transwestern

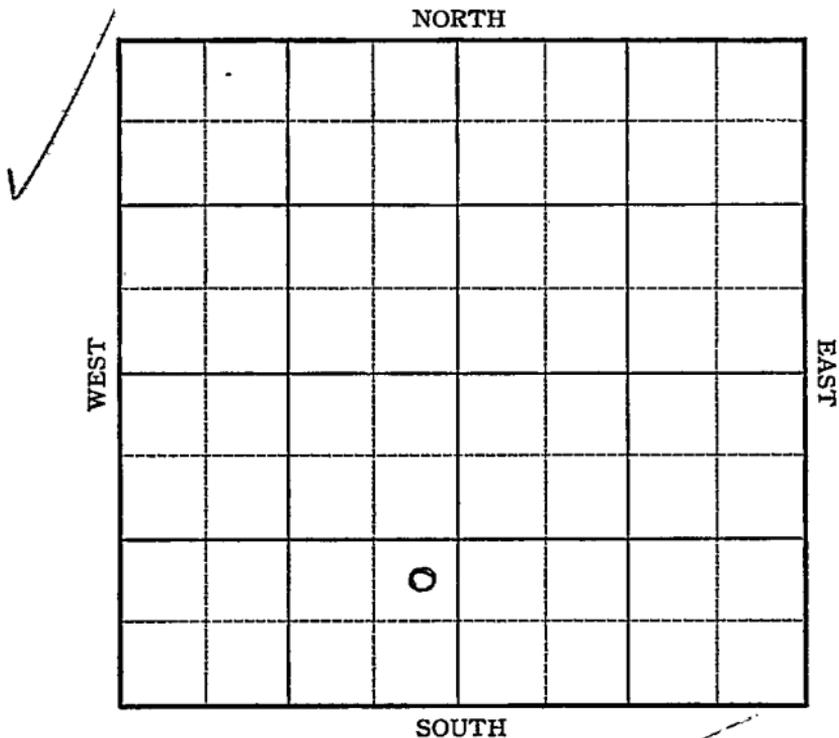

Sec. 11 Twp. 14 R. 15-W

Well No. #13 Wm. Polcyn Farm

Transwestern Company


         Ft. from N. Line

990 Ft. from S. Line

330 Ft. from E. Line

         Ft. from W. Line

Elev. 1823

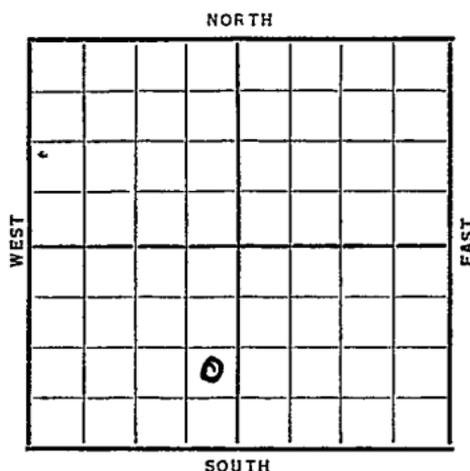

Date	REPORT
1937	
12/22	B.R.R.
12/31	R. R.
1938	
1/7	"
1/14	R U R
1/20	10"- 598' Drlg. 2113'
1/28	Drlg. 2900'
2/4	Lens. 2985' Arb. 3227 7" - 3231 T.D.
	S.O. R.U.S.T.
2/11	T.D. 3233'.
	70 shots 2999-3007'.
	Cleaning out.
2/18	Gorham 3237'. Pay 3237-41' T.D.
	3000' oil.
	<b>OVER</b>

1938

2/23 7" @ 3231'.

Gorham 3237'.

T.D. 3241'.

Potential 1361 bbls.

**COMPLETED**



Map No. 72 Sec. 11 Twp. 14 R. 15WWell No. 13 Wm. Polcyn  
Transwestern Company

Contractor

## COMPLETED

NE SE SW

\_\_\_\_\_ Ft. from N. Line

<sup>\*</sup>  
990 Ft. from S. Line330 Ft. from E. Line

\_\_\_\_\_ Ft. from W. Line

## SECTION PLAT

	0		

Location \_\_\_\_\_

Rig up \_\_\_\_\_

Drilling and Remarks:

*Rot-1361*

## RECORD

Cased 7 in., 3231 ft.Sand Gerham 3237

Gas \_\_\_\_\_

Oil \_\_\_\_\_

Total Depth 3241

## PRODUCTION

1st 24 hrs. Nat. \_\_\_\_\_

1st 24 hrs. after shot \_\_\_\_\_

Gas \_\_\_\_\_ Cu. Ft.

Dry Hole \_\_\_\_\_

Abandoned \_\_\_\_\_

Date

FEB 23 1938 19H. D. Hatfield Scout