

Section 11 Township 14 Range 15-W

#2 William Polcyn


Well Number *2 W. Polcyn "C"*

Company Transwestern Oil.

NORTH



WEST

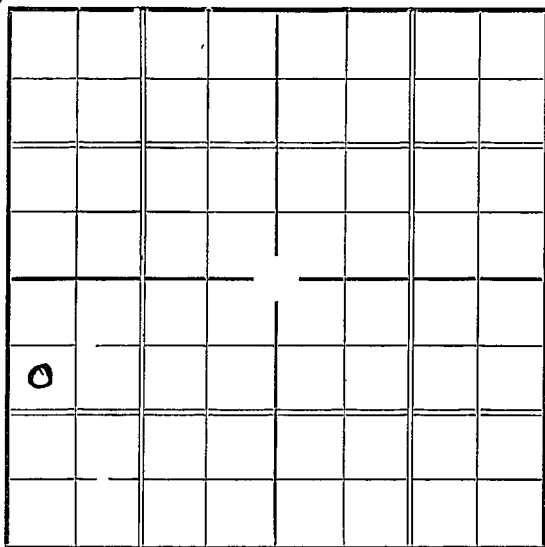

EAST

SOUTH



Sec. 11 Twp. 14 R. 15-W

Well No. #2 ~~W. Polcyn~~ ^{William Polcyn} ~~UG~~ Farm


Transwestern Oil Company

990 Ft. from N. Line

_____ Ft. from S. Line

_____ Ft. from E. Line

330 Ft. from W. Line

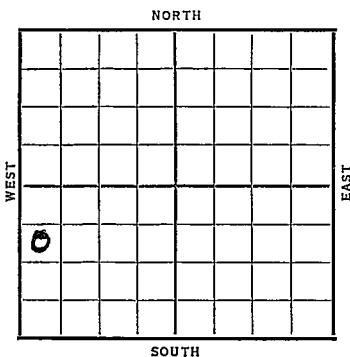

1949	REPORT
2/24	Rigging up
3/4	10" @ 638'. WOC.
3/11	Drlg. 2450'.
3/18	7" @ 3240 WOC
3/25	Gorham 3260'. T.D. 3263½'. 2700' oil in hole.
3/31	Gorham sd. 3260'. T. D. 3263½'. Potential 688.
	COMPLETED

Russell **KANSAS**

Map No. _____ Sec. 11 Twp. 14 R. 15W

Well No. 2 St. Polym "C"

Transwestern Oil Company

Contractor _____

SECTION PLAT

990 Ft. from N. Line

_____ Ft. from S. Line

_____ Ft. from E. Line

330 Ft. from W. Line

FIRST REPORT

Location _____

Rig up _____

Drilling and Remarks:

Rigging up
SJL

RECORD

Cased _____ in., _____ ft.

Sand _____

Gas _____

Oil _____

Total Depth _____

PRODUCTION

1st 24 hrs. Nat. _____

1st 24 hrs. after shot _____

Gas _____ Cu. Ft.

Dry Hole _____

Abandoned _____

Date

FEB 24 1937 19

S. J. LEWIS

Scout

KANSAS

Map No. 72 Sec. 11 Twp. 14 R. 15W

Well No. 2 William Polyn

Transwestern Oil Company

Contractor

SECTION PLAT

0			

990 Ft. from N. Line

_____ Ft. from S. Line

_____ Ft. from E. Line

330 Ft. from W. Line

CORRECTION

Location _____

Rig up _____

Drilling and Remarks:

*They have changed
the lease from
Polyn "C" to the
William Polyn*

RECORD

Cased _____ in., _____ ft.

Sand _____

Gas _____

Oil _____

Total Depth _____

PRODUCTION

1st 24 hrs. Nat. _____

1st 24 hrs. after shot _____

Gas _____ Cu. Ft.

Dry Hole _____

Abandoned _____

Date

3/11 1937

S. J. LEWIS Scout

KANSAS *Russell.*

Map No. _____ Sec. *11* Twp. *14* R. *15W*

Well No. *2 Elm Pklyn*

Transwestern Company

Contractor _____

SECTION PLAT

990 Ft. from N. Line
 _____ Ft. from S. Line
 _____ Ft. from E. Line
330 Ft. from W. Line

<i>6</i>			

COMPLETED

Location _____

Rig up _____

Drilling and Remarks:

Gosham Sch.

3260

Potential

688

RECORD

Cased _____ in., _____ ft.

Sand _____

Gas _____

Oil _____

Total Depth *3263 1/2*

PRODUCTION

1st 24 hrs. Nat. _____

1st 24 hrs. after shot _____

Gas _____ Cu. Ft.

Dry Hole _____

Abandoned _____

Date

Mar 31 1937 19

S. J. LEWIS Scout