

Section 11 Township 14 Range 15-WWell Number 8 - W. PolcynCompany Transwestern

NORTH

WEST

EAST

SOUTH

O

Sec. 11 Twp. 14 R. 15-W

Well No. #8 W. Polcyn Farm

Transwestern _____ **Company**

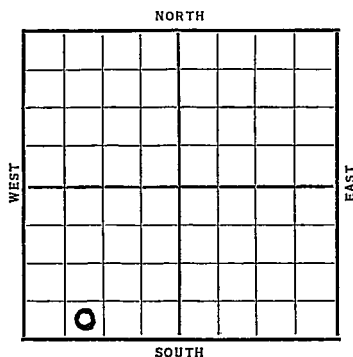
Ft. from N. Line

330 Ft. from S. Line

Ft. from E. Line

990 Ft. from W. Line

Elev. 1849

[illegible]

Map No. 72 Sec. 11 Twp. 14 R. 15^WWell No. S-W Polcyn
Transwestern Company

Contractor

FIRST REPORT

SECTION PLAT

 Ft. from N. Line330 Ft. from S. Line Ft. from E. Line990 Ft. from W. Line

0			

Location Rig up

Drilling and Remarks:

R. U. R.

RECORD

Cased in., ft.Sand Gas Oil Total Depth

PRODUCTION

1st 24 hrs. Nat. 1st 24 hrs. after shot Gas Cu. Ft.Dry Hole Abandoned

Date

JUN 23 1937

19

H. D. Hatfield

Scout

Russell

Map No. 72 Sec. 11 Twp. 14 R. 15^WWell No. S-W PolcynTranswestern Company

Contractor

COMPLETED

_____ Ft. from N. Line

330 Ft. from S. Line

_____ Ft. from E. Line

990 Ft. from W. Line

SECTION PLAT

0			

Location _____

Rig up _____

Drilling and Remarks:

Pot 885/24

Down 3 hrs

RECORD (corrected)

Cased 7 in., 3240 ft.Sand Gorham 3256

Gas _____

Oil _____

Total Depth 3260

PRODUCTION

1st 24 hrs. Nat. _____

1st 24 hrs. after shot _____

Gas _____ Cu. Ft.

Dry Hole _____

Abandoned _____

Date

JUL 21 1937² 19 H. D. Hatfield Scout