

Russell

KANSAS


Form 51-5M-4-36-Palace

Section 11 Township 14 Range 15-W

Well Number 5 Wm. Polcyn

Company Transwestern

NORTH

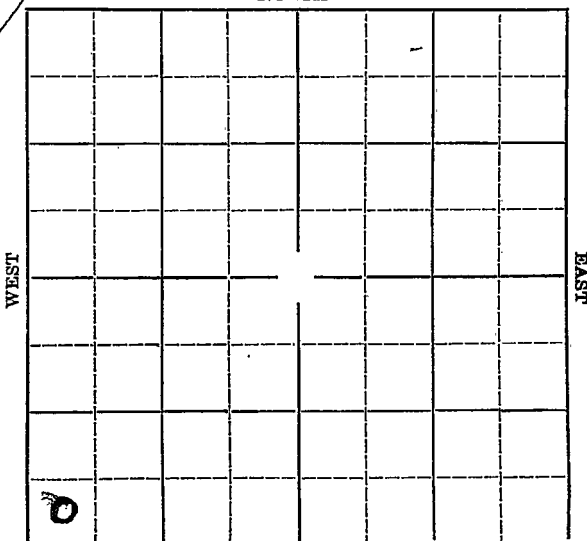

SOUTH



Sec. 11 Twp. 14 R. 15-W

Well No. #5 Wm. Polcyn Farm  
Transwestern Company


         Ft. from N. Line

330 Ft. from S. Line

         Ft. from E. Line

330 Ft. from W. Line

Elev. 1810

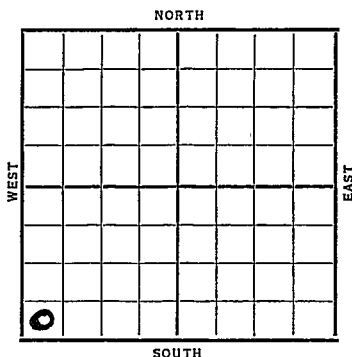

Date	REPORT
1937	
4/21	Rig
4/30	10" @ 596'. WOG.
5/7	Drlg. 2715'.
5/14	T.D. 3203'. Rng. 6".
5/21	Gorham 3217'. T.D. 3219'. 3000' oil.
5/26	7" @ 3203'. Gorham 3217'. T.D. 3219'. Pot. 785 bbls.
	<b>COMPLETED</b>

KANSAS *Russell*Map No. \_\_\_\_\_ Sec. *11* Twp. *14* R. *15W*Well No! *5 Am Polym.**Transwestern* Company

Contractor \_\_\_\_\_

## SECTION PLAT


\_\_\_\_\_ Ft. from N. Line

*330* Ft. from S. Line

\_\_\_\_\_ Ft. from E. Line

*330* Ft. from W. Line

## FIRST REPORT

Location \_\_\_\_\_

Rig up \_\_\_\_\_

Drilling and Remarks:

*Rig*

## RECORD

Cased \_\_\_\_\_ in., \_\_\_\_\_ ft.

Sand \_\_\_\_\_

Gas \_\_\_\_\_

Oil \_\_\_\_\_

Total Depth \_\_\_\_\_

## PRODUCTION

1st 24 hrs. Nat. \_\_\_\_\_

1st 24 hrs. after shot \_\_\_\_\_

Gas \_\_\_\_\_ Cu. Ft.

Dry Hole \_\_\_\_\_

Abandoned \_\_\_\_\_

Date

APR 21 1937 19

S. J. LEWIS Scout

Russell KANSAS

Map No. \_\_\_\_\_ Sec. 11 Twp. 14 R. 15<sup>w</sup>Well No. 5 - Wm PolcynTranswestern Company

Contractor

## COMPLETED

330 Ft. from N. Line330 Ft. from S. Line

\_\_\_\_\_ Ft. from E. Line

330 Ft. from W. Line

## SECTION PLAT

0			

Location \_\_\_\_\_

Rig up \_\_\_\_\_

Drilling and Remarks:

Pot - 785

## RECORD

Cased 7 in., 3203 ft.Sand Gorham 3217

Gas \_\_\_\_\_

Oil \_\_\_\_\_

Total Depth 3219

## PRODUCTION

1st 24 hrs. Nat. \_\_\_\_\_

1st 24 hrs. after shot \_\_\_\_\_

Gas \_\_\_\_\_ Cu. Ft.

Dry Hole \_\_\_\_\_

Abandoned \_\_\_\_\_

Date

MAY 26 1937 19H. D. Hatfield

Scout