


Section 11 Township 14 Range 15-W

Well No. 10 - Wm. Polcyn

Company Transwestern

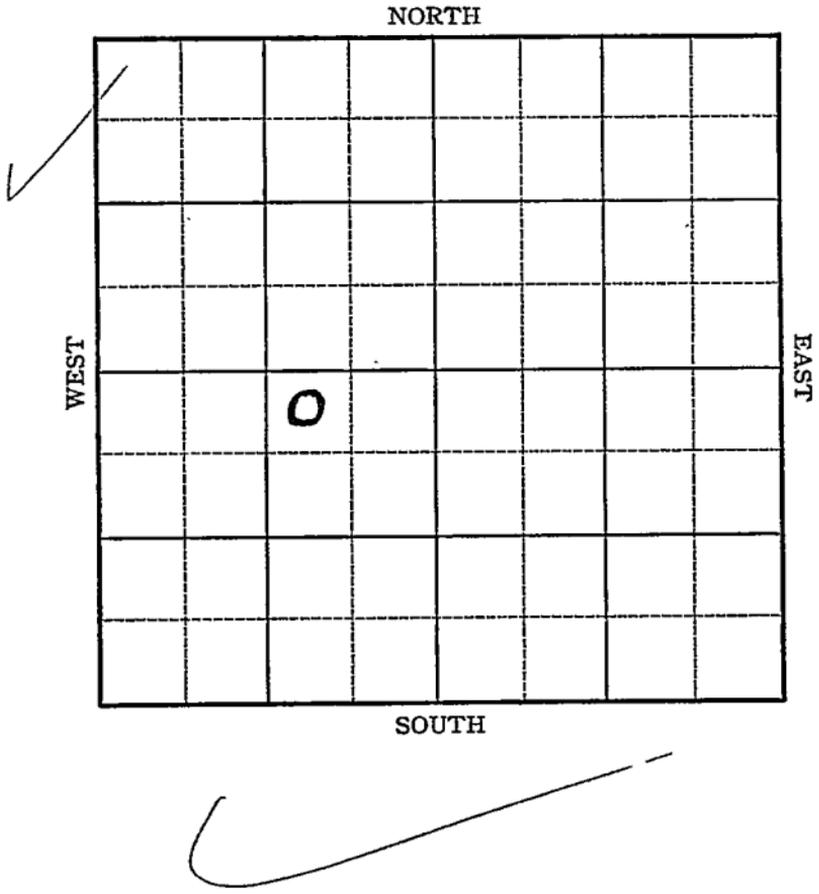

Sec. 11 Twp. 14 R. 15-W

Well No. #10 Wm. Polcyn Farm  
Transwestern Company


330 Ft. from N. Line

\_\_\_\_\_ Ft. from S. Line

990 Ft. from E. Line

\_\_\_\_\_ Ft. from W. Line

Elev. 1862

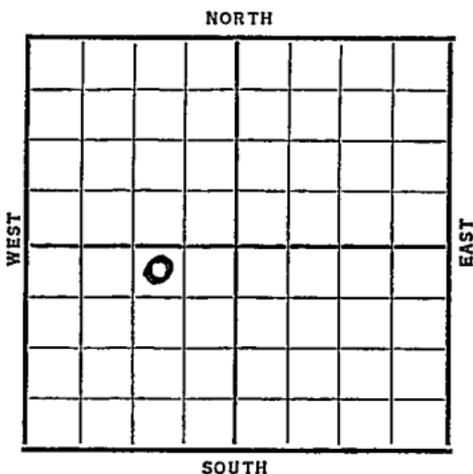

Date	REPORT
1937	
9/8	R. R.
9/17	13" @ 292'. WOC.
9/24	Drlg. 2141'.
10/2	Drlg. 2913'.
10/8	K.C. 3023'.
	Sat. 3027-28' T.D. 8" @ 3023'.
	WOC.
10/15	Pay 3053-55' T.D. 1460' oil 3
	hours. 5000 acid.
	Potential 719 bbls. May deepen.
10/22	Drlg. 3243'.
10/27	8" @ 3023'.
	K.C. 3023'.
	T.D. 3063'.
	5000 acid.
	P. 187 bbls. 4 hrs & 184 bbls.
	4 hrs.
	Potential 1105 bbls.

COMPLETED

KANSAS

Map No. \_\_\_\_\_ Sec. 11 Twp. 14 R. 15<sup>w</sup>Well No. 10-20<sup>m</sup> PolcynTranswestern Company

Contractor \_\_\_\_\_

## FIRST REPORT

## SECTION PLAT

330 Ft. from N. Line

\_\_\_\_\_ Ft. from S. Line

990 Ft. from E. Line

\_\_\_\_\_ Ft. from W. Line

	0		

Location \_\_\_\_\_

Rig up \_\_\_\_\_

Drilling and Remarks:

## RECORD

Cased \_\_\_\_\_ in., \_\_\_\_\_ ft.

Sand \_\_\_\_\_

Gas \_\_\_\_\_

Oil \_\_\_\_\_

Total Depth \_\_\_\_\_

## PRODUCTION

1st 24 hrs. Nat. \_\_\_\_\_

1st 24 hrs. after shot \_\_\_\_\_

Gas \_\_\_\_\_ Cu. Ft.

Dry Hole \_\_\_\_\_

Abandoned \_\_\_\_\_

Date

SEP 8 1937

19

H. D. Hatfield

Scout

Russell KANSAS

Map No. \_\_\_\_\_ Sec. 11 Twp. 14 R. 15W

Well No. 10 Wm. Polcyn

Transwestern Company

Contractor

**COMPLETED**

NW NE SW

**SECTION PLAT**

330 Ft. from N. Line

\_\_\_\_\_ Ft. from S. Line

990 Ft. from E. Line

\_\_\_\_\_ Ft. from W. Line

	0		

Location \_\_\_\_\_

**RECORD**

Cased 8 in., 3023 ft.

Sand KC 3023

Gas \_\_\_\_\_

Oil \_\_\_\_\_

Total Depth 3063

**PRODUCTION**

1st 24 hrs. Nat. \_\_\_\_\_

1st 24 hrs. after shot \_\_\_\_\_

Gas \_\_\_\_\_ Cu. Ft.

Dry Hole \_\_\_\_\_

Abandoned \_\_\_\_\_

*5000 acid*

*P-187/4 + 184/4*

*Pat-1105*

Date

OCT 27 1937 19

H. D. Hatfield

Scout