


Russell
14 R. 15W

Map No. 7 ALA Sec. 11 Twp. 14 R. 15W

Well No. 1-11 R. Russell Farm _____
Darby Pat Company _____

NORTH

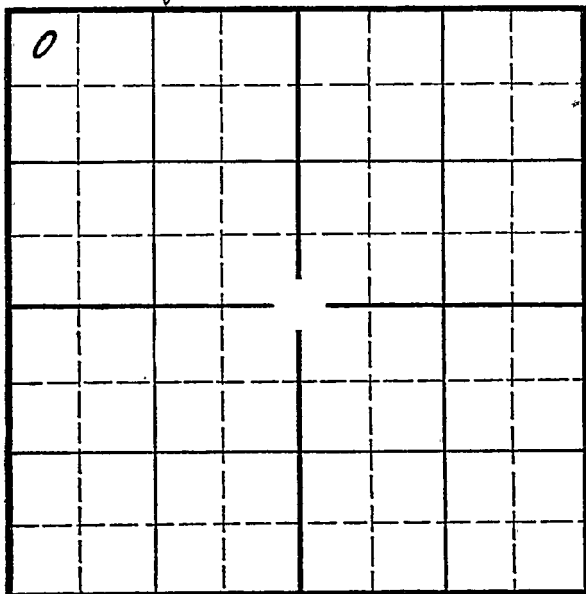

Location _____

Drilling Remarks _____

Rig Up _____

Drilling Remarks _____

RECORD

Cased _____ in. _____ ft.

Sand _____

Gas _____

Oil _____

Total Depth _____

PRODUCTION

1st 24 hrs. Nat. _____

1st 24 hrs. after shot _____

Gas _____ cu. ft. _____

Dry Hole _____

Abandoned _____

Russell

Map No. KANSAS Sec. 11 Twp. 14 R. 15^w

Well No. 1- G. A. Dummer Farm

Barby Pit Company


330 Ft. from N. Line

_____ Ft. from S. Line

_____ Ft. from E. Line

330 Ft. from W. Line

Elev. 1868

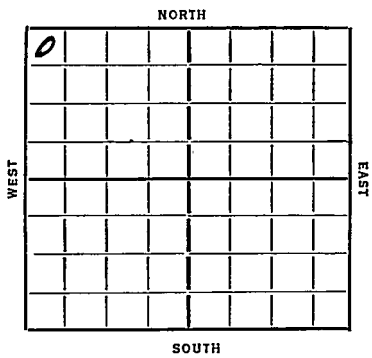

REPORT

~~1/36~~
 1/8 BK.
 1/17 Riv
 1/24 —
 1/31 Dly 635 12" 471
 2/7 " 1585 Aubry 903 10" 915
 2/14 SD 2275
 2/21 8" 2530
 2/28 8" 2526 Lous. 3041
 AQ 3065-70 TD ~~3077~~ 3125
 Aug
 3/6 6" 3117 TD 3273 WR 6"
 3/18 Norman 3289
 TD 3291
 1142 Natural

COMPLETED

KANSAS

Map No. 72 Sec. 11 Twp. 14 R. 15W

Well No. 1 - G. A. Dumber

Darby Pet Company

Contractor

SECTION PLAT

330 Ft. from N. Line

.....Ft. from S. Line

.....Ft. from E. Line

330 Ft. from W. Line

0			

FIRST REPORT

Location.....

Rig up.....

Drilling and Remarks:

B.R.

RECORD

Cased.....in.,ft.

Sand.....

Gas.....

Oil.....

Total Depth.....

PRODUCTION

1st 24 hrs. Nat.....

1st ~~24~~ hrs. after shot.....

Gas.....Cu. Ft.

Dry Hole.....

Abandoned.....

Date

ORVAL MANNSCHRECK

JAN 8 1936

Scout

Map No. 72 Sec. 11 Twp. 14 R. 15W

Well No. 1 - Dumber

Barby Company

Contractor

COMPLETED

SECTION PLAT

330 Ft. from N. Line

..... Ft. from S. Line

..... Ft. from E. Line

330 Ft. from W. Line

0			

Location.....

Rig up.....

Drilling and Remarks:

1142 natural

RECORD

Cased..... in., ft.

Sand Gorham 3289

Gas.....

Oil.....

Total Depth 3291

PRODUCTION

1st 24 hrs. Nat.....

1st 24 hrs. after shot.....

Gas..... Cu. Ft.

Dry Hole.....

Abandoned.....

Date

MAR 18 1936

192.....

ORVAL MANNSCHRECK

Scout