


KANSAS Russell

FORM 51 10M 12-46 PETROL

Section 11 Township 14 Range 14W

Well No. 4 Boxberger

Company H. H. Blair

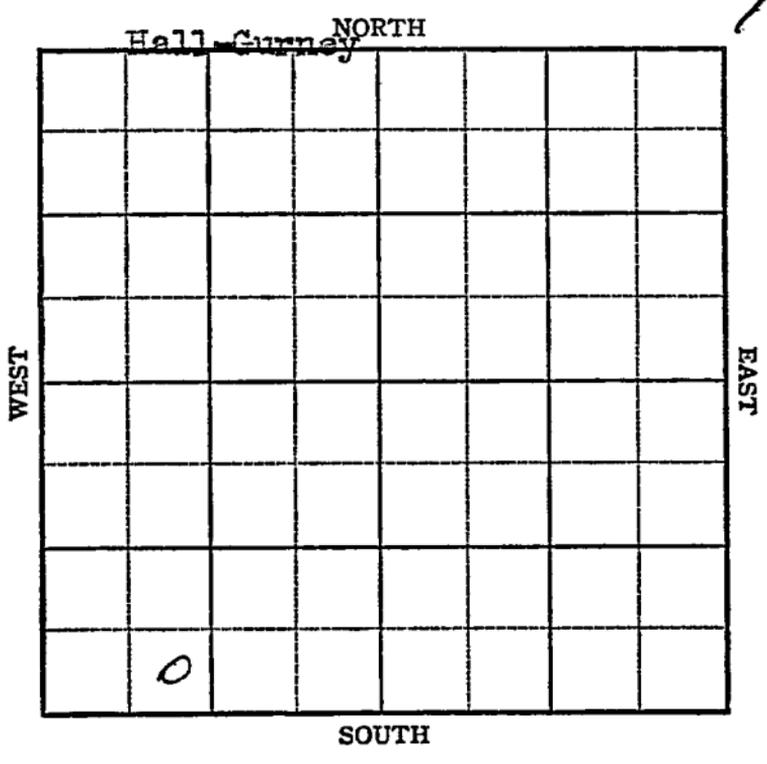

Sec. 11 _____ Twp. 14 _____ R. 14-W _____

Well No. 4 Boxberger _____ Farm _____

H. H. Blair _____ Company _____


Hall-Gurney Pool

_____ Ft. from N. Line

330 _____ Ft. from S. Line

_____ Ft. from E. Line

990 _____ Ft. from W. Line

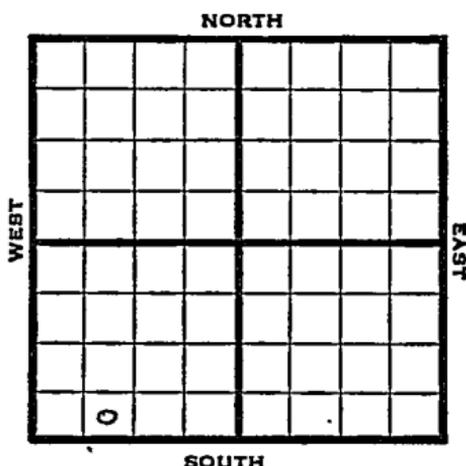

SE SW SW

1947	Elev. 1851' REPORT
9/3	380 run. csg.
9/10	12" @ 545. 830 Run 10"
9/17	Drlg. 1700'
9/24	Drlg. "2440'
10/1	8" @ 2505' Topeka 2709' Drlg. 2825'
10/8	Lansing 2993' TD 3040' 7" @ 2993' RUST
10/15	TD 3044-1400' oil 12 hrs.
10/22	"
11/5	Lans. 2993' 7" @ 2993' Pump 110 Pot Gr. 40° Total Depth 3044' COMPLETED

Map No. _____ Sec. 11 Twp. 14 R. 14W

Well No. 4 Boxberger

H. H. Blair Company

FIRST REPORT Contractor

SE SW SW

SECTION PLAT

_____ Ft. from N. Line

330 Ft. from S. Line

_____ Ft. from E. Line

990 Ft. from W. Line

Russell County

Location _____

Rig up _____

Drilling and Remarks: _____

380 run csg.

RECORD

Cased _____ in., _____ ft.

Sand _____

Gas _____

Oil _____

Total Depth _____

PRODUCTION

1st 24 hrs. Nat. _____

1st 24 hrs. after shot _____

Gas _____ Cu. Ft.

Dry Hole _____

Abandoned _____

Date

SEP 3 1947 19

S. J. LEWIS Scout

