


Section 11 Township 14 Range 14 W

Well No. #9 Boxberger

Company Texas Co.

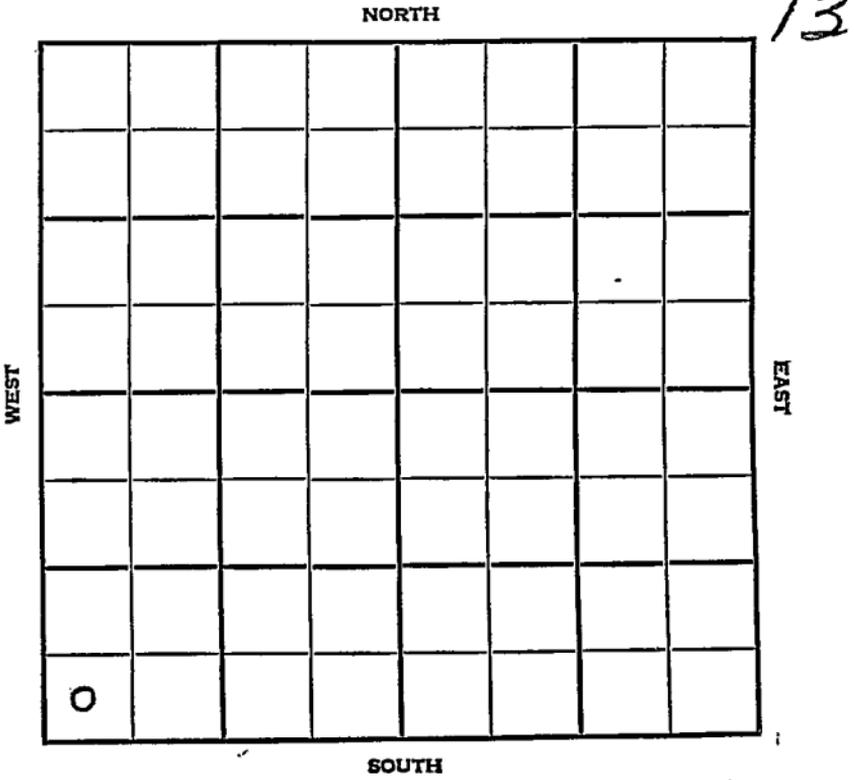

Russell

KANSAS

SEC. 11	TWP. 14	R. 11W
------------	------------	-----------

WELL NO.

#9 Boxberger

FARM

COMPANY

Texas Company

CONTRACTOR

Stickle


_____ Ft. from N. Line

_____ Ft. from S. Line

_____ Ft. from E. Line

_____ Ft. from W. Line

SW SW SW (Twin)

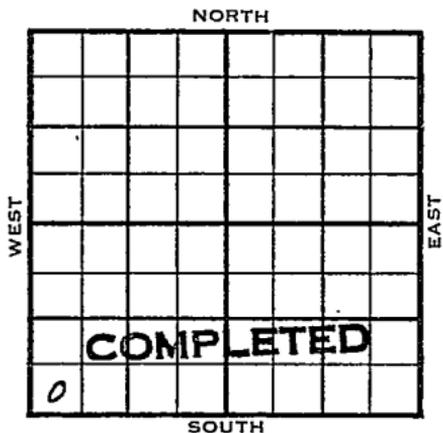

1956	ELEVATION	REPORT
------	-----------	--------

2-15 MIR

County Russell Elev. _____
 Sec. 11 Twp. 11 Rge. 11W
 Company Texas Company
 Farm Name Boxberger No. 9

TOPS	DEPTH	LOG	DATUM
Anh. <u>1</u>			
Tp.			
H.			
Tr.			
Dg.			
Bl.			
L.			
K.C.			
B.K.C.			
Ce.			
C.			
M.			
M.			
K.			
Mz.			
Me.			
V.			
S.			
S.			
A			
R.			
PE.			
G.			
T.D.			

Loc. in Sec. _____
SW SW SW
(twin)
 Geol. _____
 Contr. _____
Stickle
 Pool _____

FIRST REPORT
 FEB 15 5
 0

Date Comm. M I R

~~11~~

Co.
Lse.
No.
Sec.
T.
R.

County **Russell** Elev. **1853**
 Sec. **11** Res. **D/W**
 Company **Texas Company**
 Farm Name **Boxberger** No. **9**

TOPS	DEPTH	LOG	DATUM	Loc. in Sec.
Abk		830		SW SW SW
Tp. <i>TAK</i>		2436		(twin) 75'E
H. <i>TP</i>		2701		
Tr. <i>HA</i>		2930		
Dp.				
Bl.				
L.		2990	1137	Geol.
<i>Reag</i>		3260	1407	Contr.
RXC.				Stickle
Ce.				Pool
C.				
M.				
M.				
K.				
Mz.				
Me.				
V.				
S.				
S.				
A.				
R.	<i>3259</i>		<i>1406</i>	COMPLETE
PC				
G.				
TD	<i>3262</i>			

Date Comm. **MAR 7 1956**
M I R FEB 22 '56 2-14-56 10 3/4 835
1625 cor 2277-2427 on 27'
2783 FEB 29 '56 7" @ 3261 / woc
MAR 7 '56 co 3262 & 7 Bot + 1 BW
pk 2 hrs 500' o.B P 42 Bot
4 1/2 BW in 8 hrs comp.
for 25 Bot + Trace w/c