


KANSAS

Russell County

Section 11 Township 14 Range 14W

Well No. #2 Leo Boxberger

Company H. H. Blair

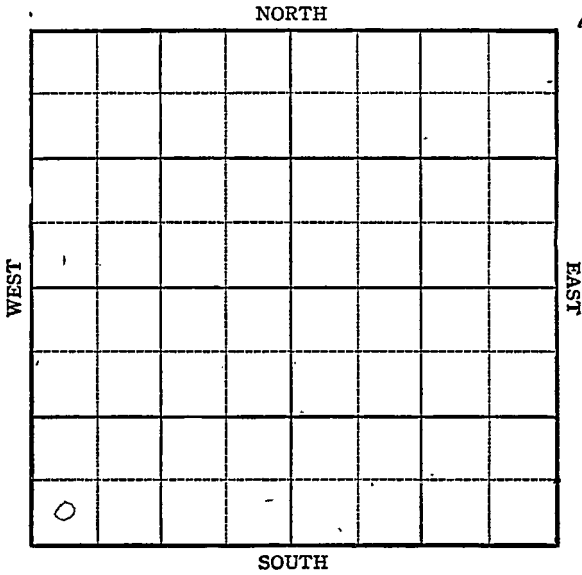

13

KANSAS

Sec. 11 Twp. 14 R. 14W

Well No. 2 Leo Boxberger Farm

H. H. Blair Company

SW/C


NORTH

\_\_\_\_\_ Ft. from N. Line

330 Ft. from S. Line

\_\_\_\_\_ Ft. from E. Line

330 Ft. from W. Line

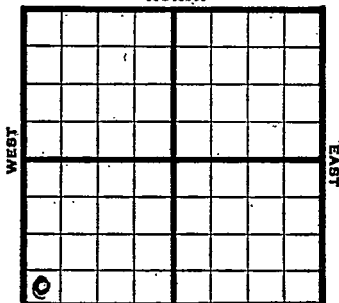

*Elev. 1855*

1944

REPORT

9-13	Location
9/21	Cable rig
9/28	Spud
10/4	15" @ 397 Drlg. 860
10/11	10" @ 840' Drlg. 2205
10/18	8" @ 2507 Anhy 830 Topeka 2706 Drlg. 2879
10/25	" " " "SD
11/2	Lans 2996 TD 3027 7" @ 2996 5000 acid Pump 18 oil per hr 22 h4w.
11/8	" " " " " "
11/16	" " " " " "
11/24	on potential
11/29	Lans 2996 7" @ 2996 TD 3027 5000 acid. Pump 238 Pot. Grav. 39.0

COMPLETED

Pool Name Williamson

KANSAS

Map No. 72 Sec. 11 Twp. 14 R. 14W

Well No. 2 Geo Boxberger

H. H. Blair Company

**FIRST REPORT**

Contractor

SW/0

**SECTION PLAT**

\_\_\_\_\_ Ft. from N. Line

330 Ft. from S. Line

\_\_\_\_\_ Ft. from E. Line

330 Ft. from W. Line


Russell County

Location X

Rig up \_\_\_\_\_

Drilling and Remarks:

**RECORD**

Cased \_\_\_\_\_ in., \_\_\_\_\_ ft.

Sand \_\_\_\_\_

Gas \_\_\_\_\_

Oil \_\_\_\_\_

Total Depth \_\_\_\_\_

**PRODUCTION**

1st 24 hrs. Nat. \_\_\_\_\_

1st 24 hrs. after shot \_\_\_\_\_

Gas \_\_\_\_\_ Cu. Ft.

Dry Hole \_\_\_\_\_

Abandoned \_\_\_\_\_

Date

SEP 13 1944 19

S. J. LEWIS Scout

Pool Name WilliamsonMap No. 12 Sec. 11 Twp. 14 R. 14WWell No. 2 Leo BoxbergerH. H. Blair CompanyCOMPLETED Contractor

SW/c

## SECTION PLAT

       Ft. from N. Line330 Ft. from S. Line       Ft. from E. Line330 Ft. from W. Line

o			

RussellLocation       Rig up       

Drilling and Remarks:

Lane 29967" @ 29965000 cu ftPeny 238 BX39° E

## RECORD

Cased        in.,        ft.Sand       Gas       Oil       Total Depth 3027

## PRODUCTION

1st 24 hrs. Nat.       1st 24 hrs. after shot       Gas        Cu. Ft.Dry Hole       Abandoned       Date       NOV 29 1944 19S. I. LEWIS Scout