


Section 11 Township 14 Range 14W

Well No. 6 Leo Boxberger

Company H.H. Blair

Russell County- Hall-Gurney
NORTH Pool

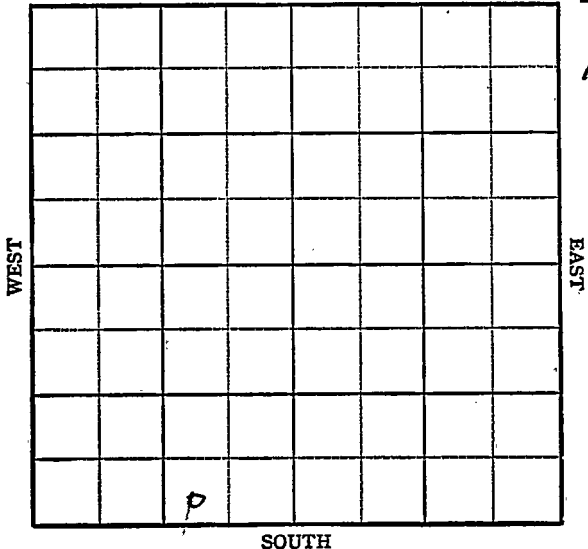

KANSAS

Russell

Sec. 11 Twp. 14 R. 14W

Well No. #6 Leo Boxberger Farm

H. H. Blair

Company

Hall-Gurney Pool


_____ Ft. from N. Line

330' Ft. from S. Line

990' Ft. from E. Line

_____ Ft. from W. Line

SW SE SW

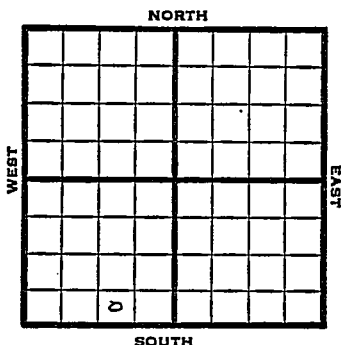

1948

Elev 1847' REPORT

12/15	Location
12/22	"
12/29	"
1/5	Rig
1/12	Drlg 225
1/19	12"@ 525'
	10"@ 827'
	Drlg 840'
1/26	Drlg 2040'
2/2	Drlg. 2270'
2/9	Lansing 2991'
	TD 2991'
	7"@ 2991'
2/16	"
2/23	TD 3042'
	Lansing 2991'
	7"@ 2991'
	5000 acid
	Pump 300 Oil Pot
	40? Gr.
	Comp

COMPLETED

Map No. _____ Sec. 11 Twp. 14 R. 14W

Well No. 6 Leo Boxberger

H. H. Blair Company

FIRST REPORT Contractor

SW SE SW

SECTION FLAT

_____ Ft. from N. Line

330 Ft. from S. Line

990 Ft. from E. Line

_____ Ft. from W. Line

Russell County

Location X

Rig up _____

Drilling and Remarks:

RECORD

Cased _____ in., _____ ft.

Sand _____

Gas _____

Oil _____

Total Depth _____

PRODUCTION

1st 24 hrs. Nat: _____

1st 24 hrs. after shot _____

Gas _____ Cu. Ft.

Dry Hole _____

Abandoned _____

Date

DEC 15 1948

19

S. J. LEWIS Scout

Kansas

Map No. K 72 Sec. 11 Twp. 14 R. 14W

Well No. 6 Leo Boxberger

H. H. Blair Company

COMPLETE

Contractor

SW SE SW

E. 1872

SECTION PLAT

_____ Ft. from N. Line

330 Ft. from S. Line

990 Ft. from E. Line

_____ Ft. from W. Line

Russell County

Location _____

Rig up _____

Drilling and Remarks:

4 hrs 2991
7" @ 2991
5000 acid
Prod 300 oil
40? SW

RECORD

Cased _____ in., _____ ft.

Sand _____

Gas _____

Oil _____

Total Depth 3042

PRODUCTION

1st 24 hrs. Nat. _____

1st 24 hrs. after shot _____

Gas _____ Cu. Ft.

Dry Hole _____

Abandoned _____

Date

FEB 23 1949 19

S. J. LEWIS

Scout