

KANSAS


Russell

Section 11 Township 14 Range 14WWell No. 7 L. BoxbergerCompany H H Blair

Hall-Gurney

NORTH

WEST

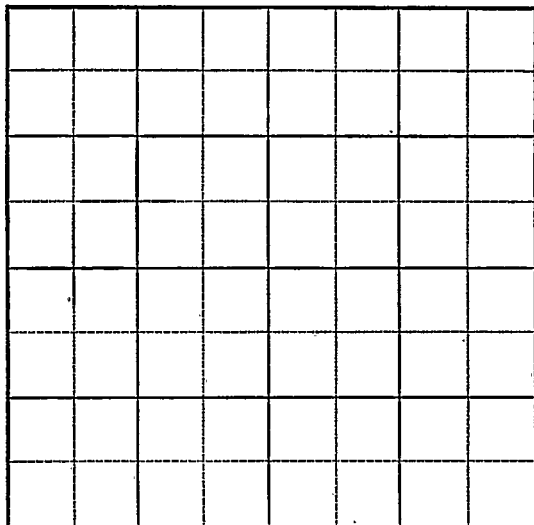

EAST


SOUTH

KANSAS

Russell

Sec. 11 Twp. 14 R. 14WWell No. #7 L. Boxberger FarmH. H. Blair CompanyHall-Gurney Ft. from N. Line990' Ft. from S. Line990' Ft. from E. Line Ft. from W. Line

NW SE SW

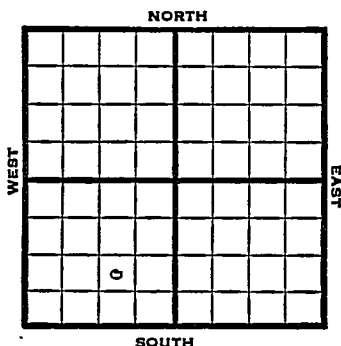

1949

Elev 1844' REPORT

2/23

Location

3/2

"

3/8

"

3/16

"

3/23

Rig

3/30

Drlg 485'

4/6

13"@ 530'

10"@ 830'

Drlg 1450'

4/12

Drlg 2370'

4/20

Drlg 2980'

4/27

Lansing 2987

7"@ 2995

TB 3042

500 acid

5/4

TD 3042'

Lans. 2987'

7"@ 2995'

5000 acid

Pump 100 Oil Pot

40⁹ Gr.

Comp

COMPLETED

Map No. _____ Sec. 11 Twp. 14 R. 14W

Well No. 7 L. Boxberger

H. H. Blair Company

FIRST REPORT Contractor

NW SE SW

SECTION PLAT

	o		

_____ Ft. from N. Line

990 Ft. from S. Line

990 Ft. from E. Line

_____ Ft. from W. Line

Russell County

Location X

Rig up _____

Drilling and Remarks:

RECORD

Cased _____ in., _____ ft.

Sand _____

Gas _____

Oil _____

Total Depth _____

PRODUCTION

1st 24 hrs. Nat. _____

1st 24 hrs. after shot _____

Gas _____ Cu. Ft.

Dry Hole _____

Abandoned _____

Date

FEB 23 1949 19

S. J. LEWIS Scout

Map No. K-12 Sec. 11 Twp. 14 R. 14W

Well No. 7 L. Boxberger

H. H. Blair Company

COMPLETE

Contractor

NW SE SW

E. 1844
SECTION PLAT

 Ft. from N. Line

990 Ft. from S. Line

990 Ft. from E. Line

 Ft. from W. Line

Russell County

Location

Rig up

Drilling and Remarks:

Log 287

2" @ 2895'

5000 ac

Prod 100 oil Bx

40 lbs

RECORD

Cased in., ft.

Sand

Gas

Oil

Total Depth CP042

PRODUCTION

1st 24 hrs. Nat.

1st 24 hrs. after shot

Gas Cu. Ft.

Dry Hole

Abandoned

Date

MAY 4 1949

19

S. J. LEWIS

Scout